

WATER WELL RECORD Form WWC-5 KSA 82a-1212

1 LOCATION OF WATER WELL: Fraction Section Number Township Number Range Number
 COUNTY: 042 HODGEMAN NE 1/4 NE 1/4 SW 1/4 06 T 23 S R 23 W

Distance and direction from nearest town or city street address of well if located within city?


BOWLES STREET JETMORE, KS

2 WATER WELL OWNER: CITY OF JETMORE

RR#, St. Address, Box # : PO BOX 8
 City, State, ZIP code : JETMORE, KS 67854-0008

Board of Agriculture, Division of Water Resources
 Application Number: 1787 28.266

3 LOCATE WELL'S LOCATION WITH AN "X" IN SECTION BOX:

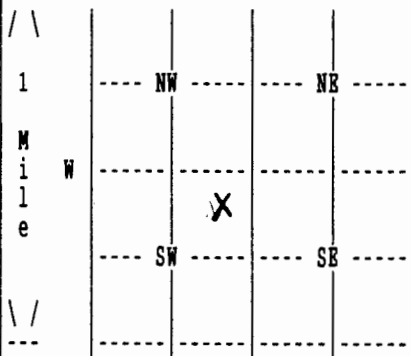

4 DEPTH OF COMPLETED WELL 360 ELEVATION: 0
 Depth(s) Groundwater Encountered 1. 0 ft. 2. 0 ft. 3. 0 ft.

WELL'S STATIC WATER LEVEL 123.5 ft. below land surface measured on mo/day/yr 06/09/05
 Pump test data: Well water was 185 ft. after 8 hours pumping 400 gpm

Estimated Yield 0 gpm: Well water was 0 ft. after 0 hours pumping 0 gpm

Bore Hole Diameter 22 in. to 360 ft., and in. to 0 ft.

WELL WATER TO BE USED AS: 05 PUB. WTR SUP

Was a chemical/bacteriological sample submitted to department? No ;
 If yes, mo/day/yr sample was submitted Water well disinfected? Yes

5 TYPE OF BLANK CASING USED: 02 PVC

CASING JOINTS: GLUED

Blank casing diameter 12 in. to 360 ft., Dia in. to 0 ft., Dia in. to 0 ft.
 Casing height above land surface 12 in., weight 15 lbs/ft. Wall thickness or gauge No. .606

TYPE OF SCREEN OR PERFORATION MATERIAL: 03 STAINLESS ST
 SCREEN OR PERFORATION OPENINGS ARE: 01 CONT. SLOT

SCREEN PERFORATED INTERVALS: From 185 ft. to 355 ft., From 0 ft. to 0 ft.
 From 0 ft. to 0 ft., From 0 ft. to 0 ft.
 GRAVEL PACK INTERVALS: From 20 ft. to 360 ft., From 0 ft. to 0 ft.
 From 0 ft. to 0 ft., From 0 ft. to 0 ft.

6 GROUT MATERIAL 02 CEMENT GROUT

Grout Intervals: From 0 ft. to 20 ft., From 0 ft. to 0 ft., From 0 ft. to 0 ft.

What is the nearest source of possible contamination: 14 ABAND. WELL

Direction from well? NORTH

How many feet? 45

FROM	TO	LITHOLOGIC LOG	FROM	TO	PLUGGING INTERVALS
0	2	02 SILT			
2	28	04 SANDY CLAY			
28	30	01 CLAY			
30	43	05 SAND			
43	50	05 SAND 13 FINE GRAVEL 14 MED GRAVEL			
50	72	19 SHALE			
72	136	31 CALICHE 23 SANDSTONE			
136	140	23 SANDSTONE			
140	178	31 CALICHE			
178	185	23 SANDSTONE 31 CALICHE			

7 CONTRACTOR'S OR LANDOWNER'S CERTIFICATION: This water well was Constructed under my jurisdiction and was completed on (mo/day/year) 06/02/05 and this record is true to the best of my knowledge and belief. Kansas Water Well Contractor's License No. 145 This Water Well Record was completed on (mo/day/yr) 08/09/05 under the business name of HENKLE DRILLING & SUPPLY by (signature)

(Continued)

WATER WELL RECORD Form WWC-5 KSA 82a-1212

1 LOCATION OF WATER WELL: Fraction Section Number Township Number Range Number
COUNTY: 042 HODGEMAN NE 1/4 NE 1/4 SW 1/4 06 T 23 S R 23 W

2 WATER WELL OWNER: CITY OF JETMORE
RR#, St. Address, Box # : PO BOX 8 Board of Agriculture, Division of Water Resources
City, State, ZIP code : JETMORE, KS 67854-0008 Application Number:

FROM	TO	LITHOLOGIC LOG
185	209	23 SANDSTONE
209	210	31 CALICHE
210	264	23 SANDSTONE 31 CALICHE
264	276	31 CALICHE
276	313	23 SANDSTONE 31 CALICHE
313	355	31 CALICHE 23 SANDSTONE
355	360	19 SHALE

7 CONTRACTOR'S OR LANDOWNER'S CERTIFICATION: This water well was Constructed under my jurisdiction and was completed on (mo/day/year) 06/02/05 and this record is true to the best of my knowledge and belief. Kansas Water Well Contractor's License No. 145 This Water Well Record was completed on (mo/day/yr) 08/09/05, under the business name of HENKLE DRILLING & SUPPLY by (signature) *Benn J. Reichert*