


WATER WELL RECORD Form WWC-5 KSA 82a-1212

1 LOCATION OF WATER WELL: Fraction Section Number Township Number Range Number
 COUNTY: 042 HODGEMAN NW 1/4 NE 1/4 SE 1/4 15 T 23 S R 23 W

Distance and direction from nearest town or city street address of well if located within city?
 FROM JETMORE; APPX 3 1/4 MILES EAST & 2 1/2 MILES SOUTH

2 WATER WELL OWNER: DEPT. OF WILDLIFE & PARKS
 RR#, St. Address, Box # : 512 SE 25TH AVE Board of Agriculture, Division of Water Resources
 City, State, ZIP code : PRATT, KS 67124-8174 Application Number:

3 LOCATE WELL'S LOCATION WITH AN "X" IN SECTION BOX:

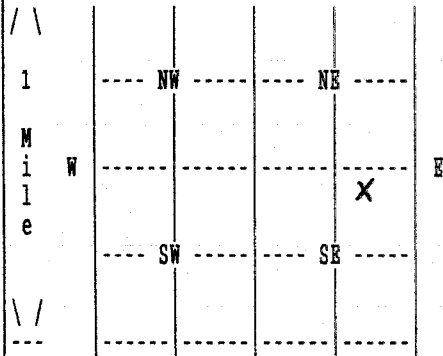

4 DEPTH OF COMPLETED WELL 260 ELEVATION: 0
 Depth(s) Groundwater Encountered 1. 0 ft. 2. 0 ft. 3. 0 ft.

WELL'S STATIC WATER LEVEL 52 ft. below land surface measured on mo/day/yr 04/28/05
 Pump test data: Well water was 0 ft. after 0 hours pumping 0 gpm

Estimated Yield 0 gpm: Well water was 0 ft. after 0 hours pumping 0 gpm

Bore Hole Diameter 10 in. to 260 ft., and in. to 0 ft.

WELL WATER TO BE USED AS: 01 DOMESTIC

Was a chemical/bacteriological sample submitted to department? No ;
 If yes, mo/day/yr sample was submitted Water well disinfected? Yes

5 TYPE OF BLANK CASING USED: 02 PVC CASING JOINTS: OTHER - CERTILOK
 Blank casing diameter 5 in. to 260 ft., Dia in. to 0 ft., Dia in. to 0 ft.
 Casing height above land surface 12 in., weight 3 lbs/ft. Wall thickness or gauge No. .265
 TYPE OF SCREEN OR PERFORATION MATERIAL: 07 PVC
 SCREEN OR PERFORATION OPENINGS ARE: 03 MILL SLOT

SCREEN PERFORATED INTERVALS: From 180 ft. to 260 ft., From 0 ft. to 0 ft.
 From 0 ft. to 0 ft., From 0 ft. to 0 ft.
 GRAVEL PACK INTERVALS: From 25 ft. to 260 ft., From 0 ft. to 0 ft.
 From 0 ft. to 0 ft., From 0 ft. to 0 ft.

6 GROUT MATERIAL 03 BENTONITE
 Grout Intervals: From 0 ft. to 25 ft., From 0 ft. to 0 ft., From 0 ft. to 0 ft.
 What is the nearest source of possible contamination: NONE OBSERVED
 Direction from well? How many feet? 0

FROM	TO	LITHOLOGIC LOG	FROM	TO	PLUGGING INTERVALS
0	1	02 SILT			
1	18	01 CLAY 31 CALICHE 05 SAND			
18	45	28 ROCK 01 CLAY			
45	57	01 CLAY			
57	61	07 FINE SAND 08 MEDIUM SAND 28 ROCK			
61	67	31 CALICHE 20 LIMESTONE			
67	74	31 CALICHE 20 LIMESTONE			
74	77	23 SANDSTONE			
77	87	31 CALICHE 23 SANDSTONE			
87	90	19 SHALE			

7 CONTRACTOR'S OR LANDOWNER'S CERTIFICATION: This water well was Constructed under my jurisdiction and was completed on (mo/day/year) 04/04/05 and this record is true to the best of my knowledge and belief. Kansas Water Well Contractor's License No. 145 This Water Well Record was completed on (mo/day/yr) 08/09/05 under the business name of HENKLE DRILLING & SUPPLY by (signature)

(Continued)

WATER WELL RECORD Form WWC-5 KSA 82a-1212

1 LOCATION OF WATER WELL: COUNTY: 042 HODGEMAN	Fraction SE 1/4 NE 1/4 SE 1/4	Section Number 15	Township Number T 23 S	Range Number R 23 W
---	----------------------------------	----------------------	---------------------------	------------------------

2 WATER WELL OWNER: DEPT. OF WILDLIFE & PARKS
RR#, St. Address, Box # : 512 SE 25TH AVE
City, State, ZIP code : PRATT, KS 67124-8174
Board of Agriculture, Division of Water Resources
Application Number:

FROM	TO	LITHOLOGIC LOG
90	97	31 CALICHE
97	102	19 SHALE 20 LIMESTONE
102	111	31 CALICHE 20 LIMESTONE
111	150	19 SHALE 20 LIMESTONE
150	164	19 SHALE 31 CALICHE 20 LIMESTONE
164	173	19 SHALE
173	187	31 CALICHE 20 LIMESTONE
187	194	23 SANDSTONE
194	212	31 CALICHE 23 SANDSTONE
212	215	31 CALICHE 19 SHALE
215	226	23 SANDSTONE 31 CALICHE
226	233	31 CALICHE 23 SANDSTONE 19 SHALE
233	243	23 SANDSTONE 31 CALICHE
243	260	31 CALICHE 23 SANDSTONE

7 CONTRACTOR'S OR LANDOWNER'S CERTIFICATION: This water well was Constructed under my jurisdiction and was completed on (mo/day/year) 04/04/05 and this record is true to the best of my knowledge and belief. Kansas Water Well Contractor's License No. 145 This Water Well Record was completed on (mo/day/yr) 08/09/05 under the business name of HENKLE DRILLING & SUPPLY by (signature) *Bern J. Leichner*