


WATER WELL RECORD Form WWC-5 KSA 82a-1212

1 LOCATION OF WATER WELL: Fraction Section Number Township Number Range Number
 COUNTY: 042 HODGEMAN NW 1/4 NE 1/4 SW 1/4 04 T 23 S R 23 W

Distance and direction from nearest town or city street address of well if located within city?
 FROM JETMORE; APPX 1 1/2 MILES EAST

2 WATER WELL OWNER: RODNEY OLIPHANT
 RR#, St. Address, Box # : RT 1 BOX 87 Board of Agriculture, Division of Water Resources
 City, State, ZIP code : OFFERLE, KS 67563-9721 Application Number: 13426

3 LOCATE WELL'S LOCATION WITH AN "X" IN SECTION BOX:

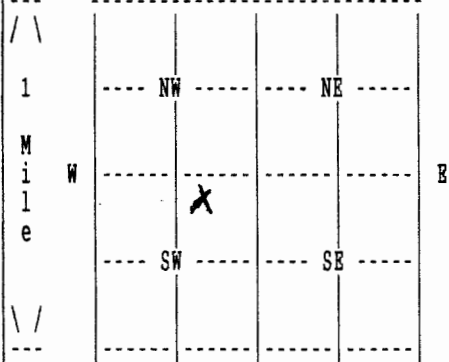

4 DEPTH OF COMPLETED WELL 75 ELEVATION: 0
 Depth(s) Groundwater Encountered 1. 0 ft. 2. 0 ft. 3. 0 ft.

WELL'S STATIC WATER LEVEL 38 ft. below land surface measured on mo/day/yr 03/24/06
 Pump test data: Well water was 49 ft. after 4 hours pumping 250 gpm

Estimated Yield 0 gpm: Well water was 0 ft. after 0 hours pumping 0 gpm

Bore Hole Diameter 24 in. to 75 ft., and in. to 0 ft.

WELL WATER TO BE USED AS: 02 IRRIGATION

Was a chemical/bacteriological sample submitted to department? No ;
 If yes, mo/day/yr sample was submitted Water well disinfected? Yes

5 TYPE OF BLANK CASING USED: 01 STEEL CASING JOINTS: WELDED
 Blank casing diameter 16 in. to 75 ft., Dia in. to 0 ft., Dia in. to 0 ft.
 Casing height above land surface 12 in., weight 37 lbs/ft. Wall thickness or gauge No. .219
 TYPE OF SCREEN OR PERFORATION MATERIAL: 01 STEEL
 SCREEN OR PERFORATION OPENINGS ARE: 01 CONT. SLOT

SCREEN PERFORATED INTERVALS: From 39 ft. to 59 ft., From 0 ft. to 0 ft.
 From 0 ft. to 0 ft., From 0 ft. to 0 ft.
 GRAVEL PACK INTERVALS: From 20 ft. to 75 ft., From 0 ft. to 0 ft.
 From 0 ft. to 0 ft., From 0 ft. to 0 ft.

6 GROUT MATERIAL 03 BENTONITE
 Grout Intervals: From 0 ft. to 20 ft., From 0 ft. to 0 ft., From 0 ft. to 0 ft.
 What is the nearest source of possible contamination: 14 ABAND. WELL
 Direction from well? NORTHEAST How many feet? 54

FROM	TO	LITHOLOGIC LOG	FROM	TO	PLUGGING INTERVALS
0	1	02 SILT			
1	27	01 CLAY 31 CALICHE			
27	39	01 CLAY			
39	54	05 SAND 11 GRAVEL 28 ROCK			
54	62	31 CALICHE 19 SHALE 20 LIMESTONE			
62	70	19 SHALE			

7 CONTRACTOR'S OR LANDOWNER'S CERTIFICATION: This water well was Constructed under my jurisdiction and was completed on (mo/day/year) 03/23/06 and this record is true to the best of my knowledge and belief. Kansas Water Well Contractor's License No. 145 This Water Well Record was completed on (mo/day/yr) 04/19/06 under the business name of HENKLE DRILLING & SUPPLY by (signature) *Rodney Oliphant*