


WATER WELL RECORD Form WWC-5 KSA 82a-1212

1 LOCATION OF WATER WELL: Fraction Section Number Township Number Range Number
 COUNTY: HODGEMAN NW 1/4 SE 1/4 SE 1/4 12 T 23 S R 23 W

Distance and direction from nearest town or city street address of well if located within city?
 JETMORE - 6 MILES EAST ON 156 HIGHWAY - 2 SOUTH & 1/4 WEST

2 WATER WELL OWNER: STONE POST DAIRY Board of Agriculture, Division of Water Resources
 RR#, St. Address, Box #: 33002 SE K ROAD Application Number:
 City, State, ZIP code: JETMORE, KS 67854-

3 LOCATE WELL'S LOCATION WITH AN "X" IN SECTION BOX: 4 DEPTH OF COMPLETED WELL 280 ELEVATION: 0
 Depth(s) Groundwater Encountered 1. 0 ft. 2. 0 ft. 3. 0 ft.

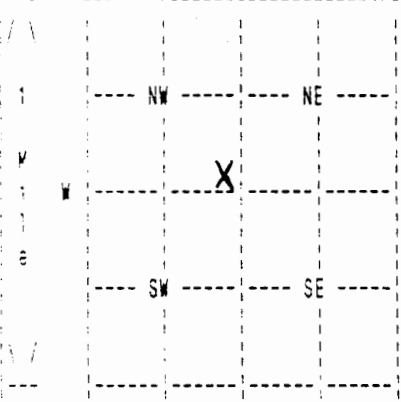

WELL'S STATIC WATER LEVEL 166 ft. below land surface measured on mo/day/yr 03/20/08
 Pump test data: Well water was 0 ft. after 0 hours pumping 0 gpm

Estimated Yield 0 gpm: Well water was 0 ft. after 0 hours pumping 0 gpm

Bore Hole Diameter in. to 0 ft., and in. to 0 ft.

WELL WATER WAS: FEEDLOW

Was a chemical/bacteriological sample submitted to department? No;
 If yes, mo/day/yr sample was submitted Water well disinfected? Yes

5 TYPE OF BLANK CASING USED: STEEL CASING JOINTS:
 Blank casing diameter 16 in. to 280 ft., Dia in. to 0 ft., Dia in. to 0 ft.
 Casing height above land surface 0 in., weight 0 lbs/ft. Wall thickness or gauge No.
 TYPE OF SCREEN OR PERFORATION MATERIAL:
 SCREEN OR PERFORATION OPENINGS ARE:

SCREEN PERFORATED INTERVALS: From 0 ft. to 0 ft., From 0 ft. to 0 ft.
 From 0 ft. to 0 ft., From 0 ft. to 0 ft.
 GRAVEL PACK INTERVALS: From 0 ft. to 0 ft., From 0 ft. to 0 ft.
 From 0 ft. to 0 ft., From 0 ft. to 0 ft.

6 GROUT MATERIAL BENTONITE
 Grout Intervals: From 0 ft. to 0 ft., From 0 ft. to 0 ft., From 0 ft. to 0 ft.
 What is the nearest source of possible contamination: FEEDYARD
 Direction from well? How many feet? 0

FROM	TO	LITHOLOGIC LOG	FROM	TO	PLUGGING INTERVALS
			0	6	TOP SOIL & CLAY
			6	32	BENTONITE GROUT
			32	150	FILL SAND
			150	162	BENTONITE GROUT
			162	280	FILL SAND
			0	0	
			0	0	
			0	0	
			0	0	
			0	0	

7 CONTRACTOR'S OR LANDOWNER'S CERTIFICATION: This water well was Plugged under my jurisdiction and was completed on (mo/day/year) 03/20/08 and this record is true to the best of my knowledge and belief. Kansas Water Well Contractor's License No. 179 This Water Well Record was completed on (mo/day/yr) 04/10/08 under the business name of JOE'S WELL SERVICE, INC. by (signature) *Judith Cisk*