

WATER WELL RECORD Form WWC-5 KSA 82a-1212


1 LOCATION OF WATER WELL: Fraction Section Number Township Number Range Number
 COUNTY: HODGEMAN NW 1/4 SE 1/4 SE 1/4 12 T 23 S R 23 W

Distance and direction from nearest town or city street address of well if located within city?
 JETMORE - 6 MILES EAST ON 156 HIGHWAY - 2 S & 1/4 WEST

2 WATER WELL OWNER: STONE POST DAIRY
 RR#, St. Address, Box #: 33002 SE K ROAD Board of Agriculture, Division of Water Resources
 City, State, ZIP code: JETMORE, KS 67854- Application Number: 42654

3 LOCATE WELL'S LOCATION WITH AN "X" IN SECTION BOX:

4 DEPTH OF COMPLETED WELL 305 ELEVATION: 0
 Depth(s) Groundwater Encountered 1. 0 ft. 2. 0 ft. 3. 0 ft.

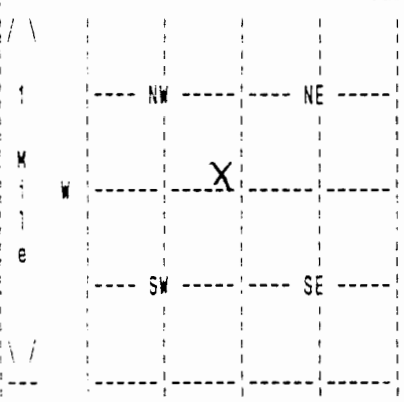

WELL'S STATIC WATER LEVEL 152 ft. below land surface measured on mo/day/yr 03/18/08
 Pump test data: Well water was 0 ft. after 0 hours pumping 0 gpm
 Estimated Yield 150 gpm: Well water was 0 ft. after 0 hours pumping 0 gpm
 Bore Hole Diameter 15 in. to 305 ft., and in. to 0 ft.
 WELL WATER TO BE USED AS: ~~DOMESTIC~~ Irrigation
 Was a chemical/bacteriological sample submitted to department? No ;
 If yes, mo/day/yr sample was submitted Water well disinfected? Yes

5 TYPE OF BLANK CASING USED: CERTA LOC CASIN CASING JOINTS: CERTA-LOC
 Blank casing diameter 8 in. to 305 ft., Dia in. to 0 ft., Dia in. to 0 ft..
 Casing height above land surface 12 in., weight 200 lbs/ft. Wall thickness or gauge No. 21
 TYPE OF SCREEN OR PERFORATION MATERIAL: PVC
 SCREEN OR PERFORATION OPENINGS ARE: SAW CUT

SCREEN PERFORATED INTERVALS: From 200 ft. to 300 ft., From 0 ft. to 0 ft.
 From 0 ft. to 0 ft., From 0 ft. to 0 ft.
 GRAVEL PACK INTERVALS: From 30 ft. to 305 ft., From 0 ft. to 0 ft.
 From 0 ft. to 0 ft., From 0 ft. to 0 ft.

6 GROUT MATERIAL BENTONITE
 Grout Intervals: From 6 ft. to 30 ft., From 0 ft. to 0 ft., From 0 ft. to 0 ft.
 What is the nearest source of possible contamination: ABANDONED WELL
 Direction from well? SOUTH How many feet? 50

FROM	TO	LITHOLOGIC LOG	FROM	TO	PLUGGING INTERVALS
0	20	01 TOPSOIL 32 TAN CLAY			
20	40	32 TAN CLAY 21 LIMESTONE 36 BLUE CLAY			
40	60	36 BLUE CLAY 29 SANDSTONE			
60	80	29 SANDSTONE 16 GRAY CLAY			
80	100	16 GRAY CLAY 11 BROWN CLAY 08 ROCK LAYERS			
100	120	29 SANDSTONE 19 LAYERS 16 GRAY CLAY			
120	140	16 GRAY CLAY			
140	160	16 GRAY CLAY 24 THINROCLAYER			
160	180	16 GRAY CLAY 29 SANDSTONE			
180	200	29 SANDSTONE (Brown)			

7 CONTRACTOR'S OR LANDOWNER'S CERTIFICATION: This water well was Constructed under my jurisdiction and was completed on (mo/day/year) 03/19/08 and this record is true to the best of my knowledge and belief. Kansas Water Well Contractor's License No. 179 This Water Well Record was completed on (mo/day/yr) 04/10/08 under the business name of JOE'S WELL SERVICE, INC. by (signature) *Quitt Crist*

(Continued)

WATER WELL RECORD Form WWC-5 KSA 82a-1212

1 LOCATION OF WATER WELL:	Fraction	Section Number	Township Number	Range Number
COUNTY: HODGEMAN	NW 1/4 SE 1/4 SE 1/4	12	T 23 S	R 23 W

2 WATER WELL OWNER: STONE POST DAIRY	Board of Agriculture, Division of Water Resources
RR#, St. Address, Box #: 33002 SE K ROAD	Application Number: 42654
City, State, ZIP code: JETMORE, KS 67854-	

FROM	TO	LITHOLOGIC LOG
200	280	29 SANDSTONE (Tan)
280	300	29 SANDSTONE 16 GRAY CLAY 36 BLUE CLAY → Tan
300	340	36 BLUE CLAY

7 CONTRACTOR'S OR LANDOWNER'S CERTIFICATION: This water well was Constructed under my jurisdiction and was completed on (mo/day/year) 03/19/08 and this record is true to the best of my knowledge and belief. Kansas Water Well Contractor's License No. 179 This Water Well Record was completed on (mo/day/yr) 04/10/08 under the business name of JOE'S WELL SERVICE, INC. by (signature) *Jessie Crick*