


WATER WELL RECORD Form WWC-5 KSA 82a-1212

1 LOCATION OF WATER WELL: Fraction Section Number Township Number Range Number
 COUNTY: HOOGENAN NE 1/4 NE 1/4 NW 1/4 1 T 23 S R 23 W

Distance and direction from nearest town or city street address of well if located within city?
 FROM JETHORE - 5 1/2 EAST ON HIGHWAY 156

2 WATER WELL OWNER: SMITH, M. CHARLIE Board of Agriculture, Division of Water Resources
 RR#, St. Address, Box #: BOX 572 Application Number: 17819
 City, State, ZIP code: JETHORE, KS 67854-

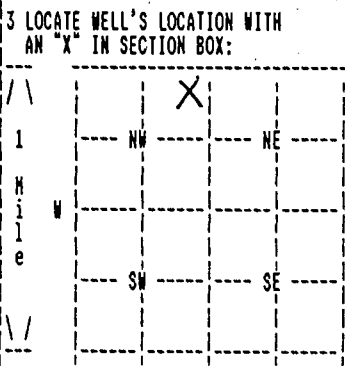

4 DEPTH OF COMPLETED WELL 76 ELEVATION: 0
 Depth(s) Groundwater Encountered 1. 0 ft. 2. 0 ft. 3. 0 ft.
 WELL'S STATIC WATER LEVEL 23 ft. below land surface measured on no/day/yr 07/28/97
 Pump test data: Well water was 0 ft. after 0 hours pumping 0 gpm
 Estimated Yield 450 gpm: Well water was 0 ft. after 0 hours pumping 0 gpm
 Bore Hole Diameter 26 in. to 76 ft., and in. to 0 ft.
 WELL WATER TO BE USED AS: IRRIGATION
 Was a chemical/bacteriological sample submitted to department? No ;
 If yes, no/day/yr sample was submitted Water well disinfected? Yes

5 TYPE OF BLANK CASING USED: PVC CASING JOINTS: GLUED
 Blank casing diameter 16 in. to 76 ft., Dia in. to 0 ft., Dia in. to 0 ft.
 Casing height above land surface 12 in., weight 200 lbs/ft. Wall thickness or gauge No. 40
 TYPE OF SCREEN OR PERFORATION MATERIAL: PVC
 SCREEN OR PERFORATION OPENINGS ARE: SAW CUT

SCREEN PERFORATED INTERVALS: From 50 ft. to 70 ft., From 0 ft. to 0 ft.
 From 0 ft. to 0 ft., From 0 ft. to 0 ft.
 GRAVEL PACK INTERVALS: From 20 ft. to 76 ft., From 0 ft. to 0 ft.
 From 0 ft. to 0 ft., From 0 ft. to 0 ft.

6 GROUT MATERIAL BENTONITE
 Grout Intervals: From 0 ft. to 20 ft., From 0 ft. to 0 ft., From 0 ft. to 0 ft.
 What is the nearest source of possible contamination: ABANDONED WELL
 Direction from well? NORTH How many feet? 40

FROM	TO	LITHOLOGIC LOG	FROM	TO	PLUGGING INTERVALS
0	20	TOPSOIL CLAY			
20	49	CLAY			
49	61	COARSE SAND GRAVEL VERY LOOSE			
61	80	CLAY BLUE SHALE			

7 CONTRACTOR'S OR LANDOWNER'S CERTIFICATION: This water well was Constructed under my jurisdiction and was completed on (no/day/year) 07/28/97 and this record is true to the best of my knowledge and belief. Kansas Water Well Contractor's License No. 179 This Water Well Record was completed on (no/day/yr) 08/06/97 under the business name of JOE'S WELL SERVICE, INC. by (signature) *Joe's Well Service*