

WATER WELL RECORD

Form WWC-5

Division of Water Resources App. No.


Well ID

MW6

Original Record Correction Change in Well Ust

1 LOCATION OF WATER WELL: County Hodgeman Fraction NE 1/4 NW 1/4 SE 1/4 SW 1/4 Section Number 6 Township Number T 23 S Range Number R 23 E W

2 WELL OWNER: Last Name: Business: KDHE Address: 1000 SW Jackson Blvd City Topeka State: KS ZIP: 66612 Street or Rural Address where well is located (if unknown, distance and direction from nearest town or intersection): -60' N of 623 S. Main, Jetmore, KS

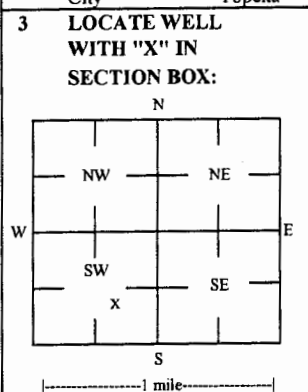

3 LOCATE WELL WITH 'X' IN SECTION BOX: 4 DEPTH OF COMPLETED WELL: 65 ft Depth(s) Groundwater Encountered: 1) 65 ft 2) ft 3) ft or 4) Dry Well WELL'S STATIC WATER LEVEL: 58.54 ft

5 Latitude: 38.08295 (decimal degrees) Longitude: 99.89404 (decimal degrees) Horizontal Datum: WGS 84 NAD 83 NAD 27 Source for Latitude/Longitude: GPS (unit make/model): Land Survey Topographic Map Online Mapper

7 WELL WATER TO BE USED AS: 1 Domestic: Household Lawn & Garden Livestock Irrigation Feedlot Industrial 2 Public Water Supply: well ID Dewatering: how many wells? Aquifer Recharge: well ID Monitoring: well ID MW6 Environmental Remediation: well ID Air Sparge Soil Vapor Extractor Recovery Injection

Was a chemical/bacteriological sample submitted to KDHE? Yes No Water well disinfected? Yes No If yes, date sample was submitted:

8 TYPE OF CASING USED: Steel PVC Other CASING JOINTS: Glued Clamped Welded Threaded Casing diameter 2 in. to 45 ft. Diameter in. to ft. Diameter in. to ft. Casing height above land surface -0.44 in. Weight lbs./ft. Well thickness or gauge No TYPE OF SCREEN OR PERFORATION MATERIAL: Steel Stainless Steel Fiberglass PVC Brass Galvanized Steel Concrete tile None used (open hole) SCREEN OR PERFORATION OPENINGS ARE: Continuous Slot Mill Slot Gauze Wrapped Torch Cut Drilled Holes Other (Specify) Louvered Shutter Key Punched Wire Wrapped Saw Cut None (Open Hole) SCREEN-PERFORATED INTERVALS: From 45 ft. to 65 ft. From ft. to ft. From ft. to ft. GRAVEL PACK INTERVALS: From 43 ft. to 65.5 ft. From ft. to ft. From ft. to ft.

9 GROUT MATERIAL: Neat cement Cement grout Bentonite Other Concrete: 0-0.5' Grout intervals: From 0.5 ft. to 41 ft. From 41 ft. to 43 ft. From ft. to ft.

Nearest source of possible contamination: Septic Tank Lateral Lines Pit Privy Livestock Pens Insecticide Storage Sewer Lines Cess Pool Sewage Lagoon Fuel Storage Abandoned Water Well Watertight Sewer Lines Seepage Pit Feedyard Fertilizer Storage Oil Well / Gas Well Other (Specify) Direction from well? S Distance from well? ~90 ft

Table with 6 columns: 10 FROM, TO, LITHOLOGIC LOG, FROM, TO, LITHO. LOG (cont.) or PLUGGING INTERVALS. Rows include lithology descriptions like 'Asphalt', 'Clayey silt to silty clay', 'Sandy silt with clay', etc.

11 CONTRACTOR'S OR LANDOWNER'S CERTIFICATION: This water well was constructed, reconstructed, or plugged under my jurisdiction and was completed on (mo-day-year) 3/29/16 and this record is true to the best of my knowledge and belief. Kansas Water Well Contractor's License No 757 This Water Well Record was completed on (mo-day-year) 4/21/16 under the business name of Larsen & Associates, Inc. Signature

SMH CONSULTANTS

~~KGS Copy~~

April 20, 2016

Larsen & Associates
 Jessica Chapman
 1311 East 25th Street, Suite B
 Lawrence, Kansas 66046
 Email: Jess@LarsenEnvironmental.com

RE: Project No. 1604DG1071

Dear Jessica:

The following is the information requested on a Monitoring Well Site, Jim Whipple Service, 623 South main, Jetmore, Hodgeman County, Kansas.

Point	North Coord.	East Coord.	Distance SE Cor. North	From S.06 West	Elev. Top Of Rim or PK Nail	Elev. Top of PVC Pipe	Latitude North	Longitude West
SE Corner S.06-T23S-R23W-	10000	10000						
MW1	11259.11	6706.66	1259.11	3293.34	2303.05	2302.80	38.08279	99.89406
MW2	11256.15	6759.10	1256.15	3240.90	2302.28	2301.99	38.08265	99.89407
MW3	11191.22	6727.49	1191.22	3272.51	2304.51	2304.00	38.08274	99.89429
MW4	11341.21	6862.43	1341.21	3137.57	2299.14	2298.69	38.08236	99.89378
MW5	11367.74	3734.49	1367.74	3265.51	2302.59	2302.36	38.08271	99.89368
MW6	11263.30	6647.28	1263.30	3352.72	2304.45	2304.01	38.08295	99.89404
Site BM	11283.24	6753.72	1283.24	3246.28				BM Elevation = 2301.74

BM Description: "□" Square cut on top of curb at northwest corner of corner of Main and Tucker.

MW1, MW2, MW3, MW4, MW5 are in the: NW¼ NE¼ SE¼ SW¼ S.06-T23S-R23W
 MW6 is in the: NE¼ NW¼ SE¼ SW¼ S.06-T23S-R23W

If you have any questions please do not hesitate in giving us a call.

Sincerely,



Tim Sloan, L.S.
 SMH CONSULTANTS