

Corrected 12/18/20

**WATER WELL PLUGGING RECORD Form WWC-5P**

KSA 82a-1212

ID NO.

MW-10

**1 LOCATION OF WATER WELL:** County: Hodgeman Fraction SE ¼ SW ¼ NE ¼ SW ¼ Section Number 6 Township Number 23 T S Range Number 23 E W

Street/Rural Address of Well Location; if unknown, distance & direction from nearest town or intersection: If at owner's address, check here ☐ South Highway 283 Jetmore, KS


**Global Positioning Systems (GPS) information:**

Latitude: 38.07778 (in decimal degrees)  
Longitude: 99.89306 (in decimal degrees)  
Elevation: 2271  
Datum: ☐ WGS84, ☒ NAD83, ☐ NAD27  
Collection Method:

**2 WATER WELL OWNER:** ADM/Collingwood Grain  
RR#, St. Address, Box #: 4666 Faries Pkwy  
City, State ZIP Code: Decatur IL 62526

☐ GPS unit (Make/Model: \_\_\_\_\_)  
☐ Digital Map/Photo, ☐ Topographic Map, ☒ Land Survey  
Est. Accuracy: ☒ < 3 m, ☐ 3-5 m, ☐ 5-15 m, ☐ > 15 m

**3 MARK WELL'S LOCATION WITH AN "X" IN SECTION BOX:**

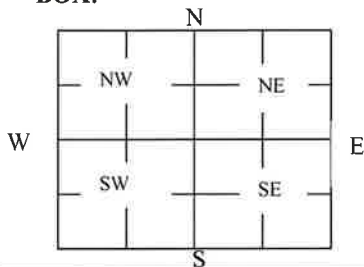

**4 DEPTH OF WELL** 39.92 ft.

WELL'S STATIC WATER LEVEL 30.97 ft

WELL WAS USED AS:

☐ Domestic ☐ Public Water Supply ☐ Dewatering  
☐ Irrigation ☐ Oil Field Water Supply ☒ Monitoring  
☐ Feedlot ☐ Domestic (Lawn & Garden) ☐ Injection Well  
☐ Industrial ☐ Air Conditioning ☐ Other \_\_\_\_\_

Was a chemical/bacteriological sample submitted to Department? Yes ☐ No ☒

**5 TYPE OF BLANK CASING USED:**

☐ Steel ☐ RMP (SR) ☐ Wrought ☐ Fiberglass ☐ Other (Specify below)  
☒ PVC ☐ ABS ☐ Asbestos-Cement ☐ Concrete Tile

Blank casing diameter 2 in. Was casing pulled? Yes ☒ No ☐ If yes, how much top 3'  
Casing height above or below land surface 36 in.

**6 GROUT PLUG MATERIAL:** ☐ Neat cement ☐ Cement grout ☒ Bentonite ☐ Other \_\_\_\_\_

Grout Plug Intervals: From 3 ft. to 39.92 ft., From \_\_\_\_\_ ft. to \_\_\_\_\_ ft., From \_\_\_\_\_ ft. to \_\_\_\_\_ ft.

What is the nearest source of possible contamination:

☐ Septic tank ☐ Seepage pit ☐ Fuel storage ☐ Other (specify below)  
☐ Sewer lines ☐ Pit privy ☒ Fertilizer storage  
☐ Watertight sewer lines ☐ Sewage lagoon ☐ Insecticide storage  
☐ Lateral lines ☐ Feedyard ☐ Abandoned water well Direction from well? SE  
☐ Cess pool ☐ Livestock pens ☐ Oil well/Gas well How many feet? 350

FROM	TO	PLUGGING MATERIALS	FROM	TO	PLUGGING MATERIALS
0	3	Native soil/gravel			
3	39.92	Bentonite			

**7 CONTRACTOR'S OR LANDOWNER'S CERTIFICATION:** This water well was plugged under my jurisdiction and was completed on (mo/day/year) 10/29/2020 and this record is true to the best of my knowledge and belief. Kansas Water Well Contractor's License No. 708 This Water Well Record was completed on (mo/day/year) 11/9/2020 under the business name of SCS Engineers by (signature) \_\_\_\_\_

Send one white copy to Kansas Department of Health & Environment, Geology Section, 1000 SW Jackson Street, Ste. 420, Topeka, KS 66612-1367. Send one copy to WATER WELL OWNER and retain one for your records.

Visit us at <http://www.kdheks.gov/waterwell/index.html> Telephone 785-296-5524.