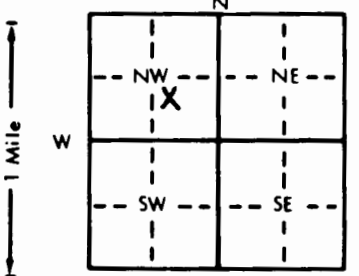


1 LOCATION OF WATER WELL: County: Hodgeman Fraction: NW 1/4 SE 1/4 NW 1/4 Section Number: 6 Township Number: T 23 S Range Number: R 23 EW

Distance and direction from nearest town or city street address of well if located within city?

2 WATER WELL OWNER: Lloyd Nusser Chevrolet RR#, St. Address, Box #: 610 S. Main City, State, ZIP Code: Jehonore, KS Board of Agriculture, Division of Water Resources Application Number: MW-2

3 LOCATE WELL'S LOCATION WITH AN "X" IN SECTION BOX:  4 DEPTH OF COMPLETED WELL: 65 ft. ELEVATION: _____ ft. Depth(s) Groundwater Encountered: 1 _____ ft. 2 _____ ft. 3 _____ ft. WELL'S STATIC WATER LEVEL: 0 ft. below land surface measured on mo/day/yr Pump test data: Well water was _____ ft. after _____ hours pumping _____ gpm Est. Yield _____ gpm: Well water was _____ ft. after _____ hours pumping _____ gpm Bore Hole Diameter: _____ in. to _____ ft., and _____ in. to _____ ft. WELL WATER TO BE USED AS: 5 Public water supply 8 Air conditioning 11 Injection well 1 Domestic 3 Feedlot 6 Oil field water supply 9 Dewatering 12 Other (Specify below) 2 Irrigation 4 Industrial 7 Lawn and garden only 10 Monitoring well Was a chemical/bacteriological sample submitted to Department? Yes No; If yes, mo/day/yr sample was submitted Water Well Disinfected? Yes No

5 TYPE OF BLANK CASING USED: 1 Steel 3 RMP (SR) 5 Wrought iron 8 Concrete tile CASING JOINTS: Glued _____ Clamped _____ 2 PVC 4 ABS 6 Asbestos-Cement 9 Other (specify below) Welded _____ Threaded _____ Blank casing diameter: 2 in. to 44.5 ft., Dia _____ in. to _____ ft., Dia _____ in. to _____ ft. Casing height above land surface: _____ in., weight _____ lbs./ft. Wall thickness or gauge No. _____ TYPE OF SCREEN OR PERFORATION MATERIAL: 1 Steel 3 Stainless steel 5 Fiberglass 8 RMP (SR) 11 Other (specify) _____ 2 Brass 4 Galvanized steel 6 Concrete tile 9 ABS 12 None used (open hole) SCREEN OR PERFORATION OPENINGS ARE: 1 Continuous slot 3 Mill slot 5 Gauzed wrapped 8 Saw cut 11 None (open hole) 2 Louvered shutter 4 Key punched 6 Wire wrapped 9 Drilled holes 10 Other (specify) _____ SCREEN-PERFORATED INTERVALS: From 44.5 ft. to 64.5 ft., From _____ ft. to _____ ft., From _____ ft. to _____ ft. GRAVEL PACK INTERVALS: From 40.4 ft. to 65 ft., From _____ ft. to _____ ft., From _____ ft. to _____ ft.

6 GROUT MATERIAL: 1 Neat cement 3 Cement grout 4 Bentonite 4 Other _____ Grout Intervals: From 0 ft. to 39.4 ft., From 39.4 ft. to 40.4 ft., From _____ ft. to _____ ft. What is the nearest source of possible contamination: 1 Septic tank 4 Lateral lines 7 Pit privy 10 Livestock pens 14 Abandoned water well 2 Sewer lines 5 Cess pool 8 Sewage lagoon 11 Fuel storage 15 Oil well/Gas well 3 Watertight sewer lines 6 Seepage pit 9 Feedyard 12 Fertilizer storage 16 Other (specify below) 13 Insecticide storage

Direction from well? _____ How many feet? _____

FROM	TO	LITHOLOGIC LOG	FROM	TO	PLUGGING INTERVALS
0	5'	Black top soil sandy (med-coarse)			
5'	10'	Lt. tan / brown sandy clay			
10	14	Orange sandy clay			
14	18	Lt. tan silty sand (VF)			
18	23	Lt. tan sandy silt, Ca threads-streaks			
23	33	Lt. tan silty sand (VF-F), caliche			
33	45	Lt. tan sand (F-red), ca nodules until 40'			
45	48	Lt. brown sandy clay (VF)			
48	65	Lt. brown sand (F-m)			

7 CONTRACTOR'S OR LANDOWNER'S CERTIFICATION: This water well was (1) constructed, (2) reconstructed, or (3) plugged under my jurisdiction and was completed on (mo/day/year) 10/23/93 and this record is true to the best of my knowledge and belief. Kansas Water Well Contractor's License No. 483 This Water Well Record was completed on (mo/day/yr) 4-13-95 under the business name of TEST by (signature) [Signature]