

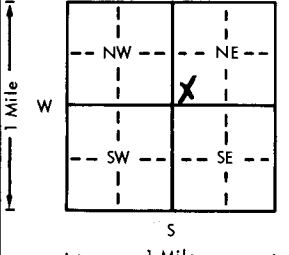
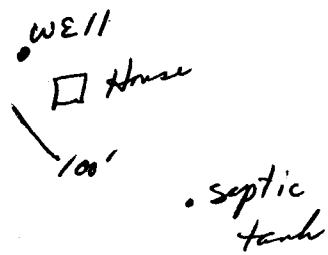
USE TYPEWRITER OR BALL
POINT PEN-PRESS FIRMLY,
PRINT CLEARLY.

WATER WELL RECORD
KSA 82a-1201-1215

Kansas Department of Health and
Environment-Division of Environment
(Water well Contractors)
Topeka, Kansas 66620

JETMORE

BCC

1. Location of well: County Hodgeman		Fraction SW 1/4 SW 1/4 NW 1/4		Section number 12	Township number T 23 S	Range number R 24 E/W
2. Distance and direction from nearest town or city: South edge of Jetmore city limits				3. Owner of well: Harry Calhoun R.R. or street: RR 1, Box 48 City, state, zip code: Jetmore, Ks 67854		
4. Locate with "X" in section below: 		Sketch map: 		6. Bore hole dia. 8" in. Completion date 6-19-79 Well depth 70 ft.		
5. Type and color of material		From	To	7. <input checked="" type="checkbox"/> Cable tool <input checked="" type="checkbox"/> Rotary <input type="checkbox"/> Driven <input type="checkbox"/> Dug <input type="checkbox"/> Hollow rod <input type="checkbox"/> Jetted <input type="checkbox"/> Bored <input type="checkbox"/> Reverse rotary		
Topsoil		0	3	8. Use: <input checked="" type="checkbox"/> Domestic <input type="checkbox"/> Public supply <input type="checkbox"/> Industry <input type="checkbox"/> Irrigation <input type="checkbox"/> Air conditioning <input type="checkbox"/> Stock <input type="checkbox"/> Lawn <input type="checkbox"/> Oil field water <input type="checkbox"/> Other		
Clay		3	35	9. Casing: Material Plastic Plastic Plastic Plastic Threaded <input type="checkbox"/> Welded <input type="checkbox"/> Surface 18 in. RMP <input type="checkbox"/> PVC Glue Weight <input type="checkbox"/> lbs./ft. Dia. 5 in. to 50 ft. depth Wall Thickness: inches or Dia. <input type="checkbox"/> in. to <input type="checkbox"/> ft. depth gage No. 250		
Sandy clay		35	40	10. Screen: Manufacturer's name Jess & Lowell Type Plastic Dia. 5" Slot/gauze 1/4 Length 20' Set between 50 ft. and 70 ft. Gravel pack? yes Size range of material 1/4		
Clay		40	50	11. Static water level: 40 ft. below land surface Date 6-19-79 mo./day/yr.		
Gravel		50	70	12. Pumping level below land surfaces: N/A ____ ft. after ____ hrs. pumping ____ g.p.m. ____ ft. after ____ hrs. pumping ____ g.p.m. Estimated maximum yield ____ g.p.m.		
BROCK 70'				13. Water sample submitted: ____ mo./day/yr. Yes <input checked="" type="checkbox"/> No <input type="checkbox"/> Date ____		
40				14. Well head completion: <input checked="" type="checkbox"/> Pitless adapter 15 inches above grade		
30' sat thick				15. Well grouted? yes With: <input checked="" type="checkbox"/> Neat cement <input type="checkbox"/> Bentonite <input type="checkbox"/> Concrete Depth: From 0 ft. to 15 ft.		
in Alluvium				16. Nearest source of possible contamination: ft. 100 Direction SE Type septic Well disinfected upon completion? <input checked="" type="checkbox"/> Yes <input type="checkbox"/> No		
				17. Pump: Manufacturer's name Unknown-customers old Model number pump HP ____ Volts ____ Length of drop pipe 45 ft. capacity ____ g.p.m. Type: <input checked="" type="checkbox"/> Submersible <input type="checkbox"/> Turbine <input type="checkbox"/> Jet <input type="checkbox"/> Reciprocating <input type="checkbox"/> Centrifugal <input type="checkbox"/> Other		
18. Elevation:		19. Remarks:		20. Water well contractor's certification: This well was drilled under my jurisdiction and this report is true to the best of my knowledge and belief. Cragg Well Drilling MI Business name License No. ____ Address Bodge City, Ks 67801 Signed ____ Date 6-28-79 Authorized representative		
Topography: <input checked="" type="checkbox"/> Hill <input checked="" type="checkbox"/> Slope <input type="checkbox"/> Upland <input type="checkbox"/> Valley		2290 2220 TOPO Cragg				

Forward the white, blue and pink copies to the Department of Health and Environment

Form WWC-5