

HORSE THIEF CANYON SW

KC

USE TYPEWRITER OR BALL POINT PEN-PRESS FIRMLY, PRINT CLEARLY.

WATER WELL RECORD
KSA 82a-1201-1215

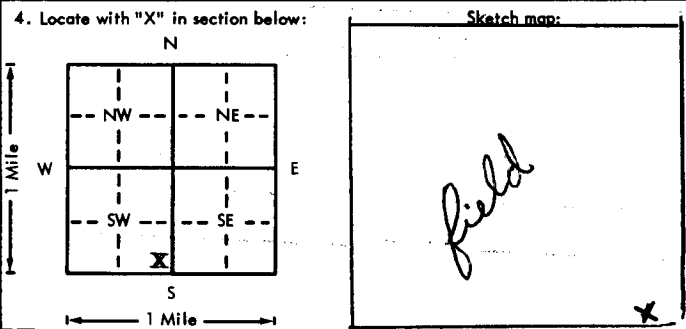
Kansas Department of Health and Environment-Division of Environment
(Water well Contractors)
Topeka, Kansas 66620

CDD

1. Location of well: County Hodgeman Fraction SE 1/4 SE 1/4 SW 1/4 Section number 31 Township number 23 Range number 26 EW

2. Distance and direction from nearest town or city: 4E, 4S,
Street address of well location if in city: of Kalvesta

3. Owner of well: Jarrell Nuss
R.R. or street:
City, state, zip code: Jetmore, Kansas 67854

4. Locate with "X" in section below:  Sketch map: field

6. Bore hole dia. 26 in. Completion date 2-8-76
Well depth 129 ft.

7. Cable tool Rotary Driven Dug
 Hollow rod Jetted Bored Reverse rotary

8. Use: Domestic Public supply Industry
 Irrigation Air conditioning Stock
 Lawn Oil field water Other

9. Casing: Material steel Height: Above or below
Threaded Welded Surface 12 in.
RMP PVC Weight 31 lbs./ft.
Dia. 16 in. to 80 ft. depth Wall Thickness: inches or
Dia. in. to ft. depth gage No.

10. Screen: Manufacturer's name W. A. BROWN Enterprises
Type Freeflow Dia. 16
Slot/gauze 1/16 Length 60
Set between 80 ft. and 130 ft.
 ft. and ft.
Gravel pack Size range of material 1 to 3/4

11. Static water level: 67 mo./day/yr.
67 ft. below land surface Date 2-1-76

12. Pumping level below land surfaces:
102 ft. after 5 hrs. pumping 700 g.p.m.
 ft. after hrs. pumping g.p.m.
Estimated maximum yield 800 g.p.m.

13. Water sample submitted: mo./day/yr.
 Yes No Date

14. Well head completion:
 Pitless adapter 12 Inches above grade

15. Well grouted? Yes
With: Neat cement Bentonite Concrete
Depth: From ft. to ft.

16. Nearest source of possible contamination:
ft. 1500 Direction N Type Ir Well
Well disinfected upon completion? Yes No

17. Pump: Not installed
Manufacturer's name Western Land Roll
Model number C25250 HP 30 Volt 480
Length of drop pipe 120 ft. capacity 700 g.p.m.
Type:
 Submersible Turbine
 Jet Reciprocating
 Centrifugal Other

18. Elevation: 2621
Topography: Hill Slope Upland Valley
125
2496

19. Remarks: TOPO
BROCK 125'?
67
58 sat luck
in Og
(Use a second sheet if needed)

20. Water well contractor's certification:
This well was drilled under my jurisdiction and this report is true to the best of my knowledge and belief.
Knoefler Bros. Drilling
Business name Jetmore, License No. 130
Address Dale Knoefler Date 2-24-76
Signed Dale Knoefler Authorized representative

23
26
31
32
1/4 SE SE SW

Forward the white, blue and pink copies to the Department of Health and Environment

Form WWC-5