


WATER WELL RECORD Form WWC-5 KSA 82a-1212

1 LOCATION OF WATER WELL: Fraction Section Number Township Number Range Number
 COUNTY: HODGEMAN NE 1/4 SW 1/4 SE 1/4 32 T 23 S R 26 W

Distance and direction from nearest town or city street address of well if located within city?
 FROM KALVESTA, KS - 5 1/2 EAST ON COUNTY LINE ROAD 1/4 NORTH

2 WATER WELL OWNER: DIRKS, CHESTER Board of Agriculture, Division of Water Resources
 RR#, St. Address, Box #: 1911 HART Application Number:
 City, State, ZIP code: DODGE CITY, KS 67801-

3 LOCATE WELL'S LOCATION WITH AN "X" IN SECTION BOX: 4 DEPTH OF COMPLETED WELL 104 ELEVATION: 0
 Depth(s) Groundwater Encountered 1. 0 ft. 2. 0 ft. 3. 0 ft.

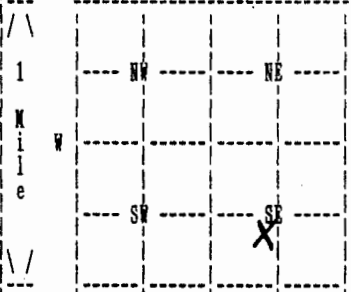

WELL'S STATIC WATER LEVEL 0 ft. below land surface measured on mo/day/yr
 Pump test data: Well water was 0 ft. after 0 hours pumping 0 gpm
 Estimated Yield 0 gpm: Well water was 0 ft. after 0 hours pumping 0 gpm
 Bore Hole Diameter in. to 0 ft., and in. to 0 ft.
 WELL WATER WAS: IRRIGATION
 Was a chemical/bacteriological sample submitted to department? No;
 If yes, mo/day/yr sample was submitted Water well disinfected? Yes

5 TYPE OF BLANK CASING USED: PVC CASING JOINTS:
 Blank casing diameter 5 in. to 104 ft., Dia in. to 0 ft., Dia in. to 0 ft.
 Casing height above land surface 0 in., weight 0 lbs/ft. Wall thickness or gauge No.
 TYPE OF SCREEN OR PERFORATION MATERIAL:
 SCREEN OR PERFORATION OPENINGS ARE:

SCREEN PERFORATED INTERVALS: From 0 ft. to 0 ft., From 0 ft. to 0 ft.
 GRAVEL PACK INTERVALS: From 0 ft. to 0 ft., From 0 ft. to 0 ft.
 From 0 ft. to 0 ft., From 0 ft. to 0 ft.

6 GROUT MATERIAL BENTONITE
 Grout intervals: From 8 ft. to 18 ft., From 70 ft. to 75 ft., From 0 ft. to 0 ft.
 What is the nearest source of possible contamination: NONE
 Direction from well? How many feet? 0

FROM	TO	LITHOLOGIC LOG	FROM	TO	PLUGGING INTERVALS
			0	8	TOP SOIL & CLAY
			8	18	BENTONITE GROUT
			18	70	FILL SAND
			70	75	BENTONITE GROUT & BENSAL
			75	104	FILL SAND
			0	0	THIS WAS AN OLD IRRIGATION WELL
			0	0	WITH 5" PVC CASING SET ON THE
			0	0	INSIDE.
			0	0	
			0	0	

7 CONTRACTOR'S OR LANDOWNER'S CERTIFICATION: This water well was Plugged under my jurisdiction and was completed on (mo/day/year) 12/27/93 and this record is true to the best of my knowledge and belief. Kansas
 Water Well Contractor's License No. 179 This Water Well Record was completed on (mo/day/yr) 12/28/93
 under the business name of JOB'S WELL SERVICE, INC. by (signature) *Justin Crick*