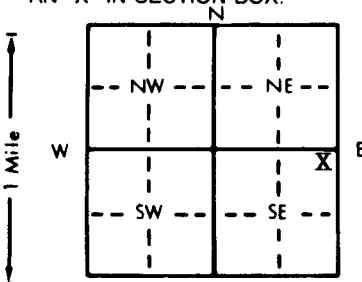


1 LOCATION OF WATER WELL: County: Hodgeman	Fraction NE 1/4 NE 1/4 SE 1/4	Section Number 26	Township Number T 23 S	Range Number R 26 EW
--	---	-----------------------------	----------------------------------	--------------------------------

Distance and direction from nearest town or city street address of well if located within city? **From west side of Jetmore - 7 1/2 miles west on Hwy. 156, 4 miles south, 5 miles west, 2,101 ft. north & 487 ft. west.**

2 WATER WELL OWNER: RR#, St. Address, Box # : City, State, ZIP Code	Steve Ochs Route 1 - Box 69A Jetmore, Kansas 67854	Board of Agriculture, Division of Water Resources Application Number: 43,288
---	---	--

3 LOCATE WELL'S LOCATION WITH AN "X" IN SECTION BOX: 	4 DEPTH OF COMPLETED WELL: 105 ft. ELEVATION: Depth(s) Groundwater Encountered 1. ft. 2. ft. 3. ft. WELL'S STATIC WATER LEVEL 69 ft. below land surface measured on mo/day/yr 11/13/98 Pump test data: Well water was ft. after hours pumping gpm Est. Yield gpm: Well water was ft. after hours pumping gpm Bore Hole Diameter: 30 in. to 105 in. and in. to in. WELL WATER TO BE USED AS: 5 Public water supply 8 Air conditioning 11 Injection well 1 Domestic 3 Fedlot 6 Oil field water supply 9 Dewatering 12 Other (Specify below) 2 Irrigation 4 Industrial 7 Lawn and garden only 10 Monitoring well Was a chemical/bacteriological sample submitted to Department? Yes..... No..... X ; If yes, mo/day/yr sample was submitted Water Well Disinfected? Yes X No
--	---

5 TYPE OF BLANK CASING USED: 1 Steel 3 RMP (SR) 2 PVC 4 ABS	5 Wrought iron 8 Concrete tile 6 Asbestos-Cement 9 Other (specify below) 7 Fiberglass	CASING JOINTS: Glued Clamped Welded X Threaded
Blank casing diameter 16 in. to 60 ft., Dia in. to ft., Dia in. to ft. Casing height above land surface 12 in., weight 42.05 lbs./ft. Wall thickness or gauge No. .250	TYPE OF SCREEN OR PERFORATION MATERIAL: 7 PVC 10 Asbestos-cement 1 Steel 3 Stainless steel 5 Fiberglass 8 RMP (SR) 11 Other (specify) 2 Brass 4 Galvanized steel 6 Concrete tile 9 ABS 12 None used (open hole)	
SCREEN OR PERFORATION OPENINGS ARE: 1 Continuous slot 3 Mill slot 6 Wire wrapped 2 Louvered shutter 4 Key punched 7 Torch cut 8 Saw cut 11 None (open hole) 9 Drilled holes 10 Other (specify)	SCREEN-PERFORATED INTERVALS: From 60 ft. to 105 ft., From ft. to ft. From ft. to ft., From ft. to ft.	
GRAVEL PACK INTERVALS: From 26 ft. to 105 ft., From ft. to ft. From ft. to ft., From ft. to ft.		

6 GROUT MATERIAL: 1 Neat cement 2 Cement grout 3 Bentonite 4 Other	GROUT INTERVALS: From 6 ft. to 26 ft., From ft. to ft., From ft. to ft.
What is the nearest source of possible contamination: 1 Septic tank 4 Lateral lines 7 Pit privy 10 Livestock pens 14 Abandoned water well 2 Sewer lines 5 Cess pool 8 Sewage lagoon 11 Fuel storage 15 Oil well/Gas well 3 Watertight sewer lines 6 Seepage pit 9 Feedyard 12 Fertilizer storage 16 Other (specify below) 13 Insecticide storage	Direction from well? Well in feedyard How many feet?

FROM	TO	LITHOLOGIC LOG	FROM	TO	PLUGGING INTERVALS
		See attached log			

7 CONTRACTOR'S OR LANDOWNER'S CERTIFICATION: This water well was (1) constructed, (2) reconstructed, or (3) plugged under my jurisdiction and was completed on (mo/day/year) 11/25/98 and this record is true to the best of my knowledge and belief. Kansas Water Well Contractor's License No. 208 This Water Well Record was completed on (mo/day/yr) 12/1/98 under the business name of Minter-Wilson Drilling Co., Inc. by (signature) <i>Nora Keller</i>

*The
Professionals*

MINTER-WILSON DRILLING CO.

INCORPORATED

**Irrigation
and Domestic
Water Systems
Complete Installation
and Repairing**

Phone 276-8269 • P.O. Box A • GARDEN CITY, KANSAS 67846

Diamond O Feeders
Steve Ochs
Hodgeman County
5/11/98

Location: SE $\frac{1}{4}$ 26-23-26 - East of Garden City on Hwy. 156 to Kalvesta,
8 miles east, 3 $\frac{1}{2}$ miles south, 230 ft. west
& 575 ft. south
475 ft. southeast of old well

Static Water Level - 60'

Test #2

0' to 2' - Top soil
2' to 12' - Brown clay
12' to 28' - Brown white clay
28' to 38' - Gray clay
lost circulation at 38'
38' to 56' - Brown clay white rock 01
56' to 75' - Fine to medium sand and gravel - 40% cemented sand - loose 17
75' to 77' - Brown clay 01
77' to 90' - Fine to medium sand and gravel - 30% small yellow rock - loose 17
90' to 93' - Brown clay 01
93' to 95' - Shale 19 01