

CORRECTION TO WATER WELL RECORD (WWC-5)

The following correction(s) was made to the attached WWC-5 log, in order to file the item or to rectify lacking or incorrect information.

Fraction (1/4 1/4 1/4) Section-Township-Range changed:

listed as SE, 32-23S-26W

changed to NW NW SE, 32-23S-26W

Other changes: Initial statements: _____

Changed to: _____

Comments: Is just a short distance away from "north well."

verification method: Written & legal descriptions, phone call to well driller (316-855-3917), and Dodge City SW, Dodge City NW, & Horse Thief Canyon SW initials: OPed date: 8/23/2000
topo. maps

submitted by: Kansas Geological Survey, Data Resources Library, 1930 Constant Ave., Lawrence, KS 66047-3726
to: Kansas Dept of Health & Environment Bureau of Water Industrial Programs, Bldg 283, Forbes Field, KS 66620

WATER WELL RECORD Form WWC-5 KSA 82a-1212


1 LOCATION OF WATER WELL: Fraction Section Number Township Number Range Number
 COUNTY: HODGEMAN SE 1/4 1/4 1/4 32 T 23 S R 26 W

Distance and direction from nearest town or city street address of well if located within city?
 FROM HOWELL, KS. - 14 MILES NORTH AND 1/2 MILE WEST

2 WATER WELL OWNER: CHESTER DIRKS - *Sand well*
 RR#, St. Address, Box #: 1207 MCKINLEY Board of Agriculture, Division of Water Resources
 City, State, ZIP code: GREAT BEND, KS 67530- Application Number:

3 LOCATE WELL'S LOCATION WITH AN "X" IN SECTION BOX:

4 DEPTH OF COMPLETED WELL 114 ELEVATION: 0
 Depth(s) Groundwater Encountered 1. 0 ft. 2. 0 ft. 3. 0 ft.

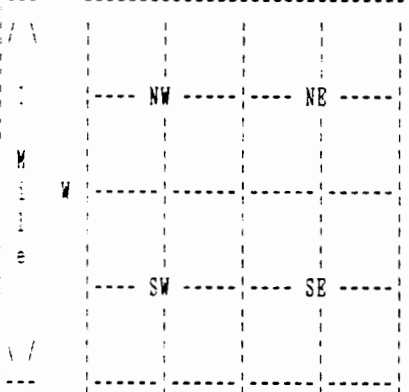

WELL'S STATIC WATER LEVEL 74 ft. below land surface measured on mo/day/yr 12/22/99
 Pump test data: Well water was 0 ft. after 0 hours pumping 0 gpm

Estimated Yield 0 gpm: Well water was 0 ft. after 0 hours pumping 0 gpm

Bore Hole Diameter in. to 0 ft., and in. to 0 ft.

WELL WATER WAS: IRRIGATION

Was a chemical/bacteriological sample submitted to department? No ;
 If yes, mo/day/yr sample was submitted Water well disinfected? Yes

5 TYPE OF BLANK CASING USED: PVC CASING JOINTS: GLUED
 Blank casing diameter 16 in. to 114 ft., Dia in. to 0 ft., Dia in. to 0 ft.
 Casing height above land surface 0 in., weight 0 lbs/ft. Wall thickness or gauge No.
 TYPE OF SCREEN OR PERFORATION MATERIAL:
 SCREEN OR PERFORATION OPENINGS ARE:

SCREEN PERFORATED INTERVALS: From 0 ft. to 0 ft., From 0 ft. to 0 ft.
 GRAVEL PACK INTERVALS: From 0 ft. to 0 ft., From 0 ft. to 0 ft.
 From 0 ft. to 0 ft., From 0 ft. to 0 ft.

6 GROUT MATERIAL BENTONITE
 Grout Intervals: From 0 ft. to 0 ft., From 0 ft. to 0 ft., From 0 ft. to 0 ft.
 What is the nearest source of possible contamination: NONE
 Direction from well? How many feet? 0

FROM	TO	LITHOLOGIC LOG	FROM	TO	PLUGGING INTERVALS
			0	7	TOP SOIL & CLAY
			7	15	BENTONITE
			15	70	FILL SAND
			70	75	BENTONITE
			75	114	FILL SAND
			0	0	
			0	0	
			0	0	
			0	0	
			0	0	

7 CONTRACTOR'S OR LANDOWNER'S CERTIFICATION: This water well was Plugged under my jurisdiction and was completed on (mo/day/year) 12/22/99 and this record is true to the best of my knowledge and belief. Kansas Water Well Contractor's License No. 179 This Water Well Record was completed on (mo/day/yr) 01/21/00 under the business name of JOB'S WELL SERVICE, INC. by (signature) *David Creek*