


WATER WELL RECORD Form WWC-5 KSA 82a-1212

1 LOCATION OF WATER WELL: Fraction Section Number Township Number Range Number
 COUNTY: HODGEMAN NE 1/4 NE 1/4 NE 1/4 27 T 23 S R 26 W

Distance and direction from nearest town or city street address of well if located within city?
 FROM JETMORE ON 156- 18 W TO RD. 204 - 3 S TO I RD. 1/4 W

2 WATER WELL OWNER: COSSMAN, MARY Board of Agriculture, Division of Water Resources
 RR#, St. Address, Box #: 13757 SW I RD. Application Number:
 City, State, ZIP code: JETMORE, KS 67854-

3 LOCATE WELL'S LOCATION WITH AN "X" IN SECTION BOX:

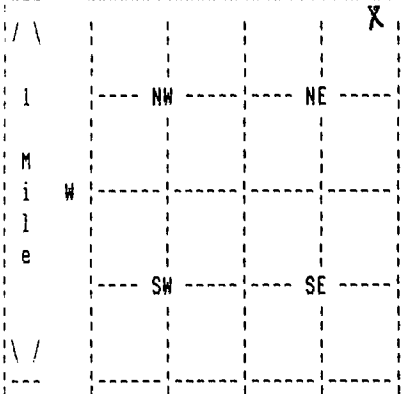

4 DEPTH OF COMPLETED WELL 120 ELEVATION: 0
 Depth(s) Groundwater Encountered 1. 0 ft. 2. 0 ft. 3. 0 ft.

WELL'S STATIC WATER LEVEL 77 ft. below land surface measured on mo/day/yr 07/23/10
 Pump test data: Well water was 0 ft. after 0 hours pumping 0 gpm

Estimated Yield 45 gpm: Well water was 0 ft. after 0 hours pumping 0 gpm

Bore Hole Diameter 10 in. to 120 ft., and in. to 0 ft.

WELL WATER TO BE USED AS: DOMESTIC

Was a chemical/bacteriological sample submitted to department? No ;
 If yes, mo/day/yr sample was submitted Water well disinfected? Yes

5 TYPE OF BLANK CASING USED: CERTA LOC CASIN CASING JOINTS: CERTA-LOC
 Blank casing diameter 5 in. to 120 ft., Dia in. to 0 ft., Dia in. to 0 ft.
 Casing height above land surface 12 in., weight 200 lbs/ft. Wall thickness or gauge No. 21
 TYPE OF SCREEN OR PERFORATION MATERIAL: PVC
 SCREEN OR PERFORATION OPENINGS ARE: SAW CUT

SCREEN PERFORATED INTERVALS: From 72 ft. to 116 ft., From 0 ft. to 0 ft.
 From 0 ft. to 0 ft., From 0 ft. to 0 ft.
 GRAVEL PACK INTERVALS: From 26 ft. to 72 ft., From 0 ft. to 0 ft.
 From 116 ft. to 120 ft., From 0 ft. to 0 ft.

6 GROUT MATERIAL BENTONITE
 Grout Intervals: From 5 ft. to 26 ft., From 0 ft. to 0 ft., From 0 ft. to 0 ft.
 What is the nearest source of possible contamination: ABANDONED WELL
 Direction from well? NORTHWEST How many feet? 15

FROM	TO	LITHOLOGIC LOG	FROM	TO	PLUGGING INTERVALS
0	20	01 TOPSOIL 35 CALACHIE			
20	30	02 FINE SAND			
30	40	35 CALACHIE			
40	60	35 CALACHIE 14 WHITE CLAY			
60	80	37 FIN-COAR SAN			
80	100	37 FIN-COAR SAN 06 SMALL GRAVEL			
100	110	28 SAND 14 WHITE CLAY 19 LAYERS			
110	120	07 BLUE SHALE			

7 CONTRACTOR'S OR LANDOWNER'S CERTIFICATION: This water well was Constructed under my jurisdiction and was completed on (mo/day/year) 07/24/10 and this record is true to the best of my knowledge and belief. Kansas Water Well Contractor's License No. 179 This Water Well Record was completed on (mo/day/yr) 07/30/10 under the business name of JOE'S WELL SERVICE, INC. by (signature) *Julius Creek*