

CORRECTION(S) TO WATER WELL RECORD (WWC-5)

(to rectify lacking or incorrect information)

County: Finney

Location listed as:

Location ~~changed to~~:

Section-Township-Range: _____

27-23 S-28 W

Fraction ($\frac{1}{4}$ $\frac{1}{4}$ $\frac{1}{4}$): _____

SE SE SW

Other changes: Initial statements: Gray County

Changed to: Finney County

Comments: _____

verification method: written & legal descriptions, position on plat map, other well plugging record for same owner at same location, and mapping tool on KGS website. initials: DRL date: 12/11/2006

submitted by: Kansas Geological Survey, Data Resources Library, 1930 Constant Ave., Lawrence, KS 66047-3726
to: Kansas Dept of Health & Environment, Bureau of Water, 1000 SW Jackson, Suite 420, Topeka, KS 66612-1367.


WATER WELL RECORD Form WWC-5 KSA 82a-1212

1 LOCATION OF WATER WELL: Fraction Section Number Township Number Range Number
 COUNTY: GRAY SE 1/4 SE 1/4 SW 1/4 27 T 23 S R 28 W

Distance and direction from nearest town or city street address of well if located within city?
 FROM CIMARRON - 15 MILES NORTH, 2 WEST, 1 NORTH & 1/2 WEST

2 WATER WELL OWNER: DIRKS, EARLE Board of Agriculture, Division of Water Resources
 RR#, St. Address, Box #: 300 N. 6TH ST. Application Number:
 City, State, ZIP code: CIMARRON, KS 67835- Application Number:

3 LOCATE WELL'S LOCATION WITH AN "X" IN SECTION BOX: 4 DEPTH OF COMPLETED WELL 160 ELEVATION: 0
 Depth(s) Groundwater Encountered 1. 0 ft. 2. 0 ft. 3. 0 ft.

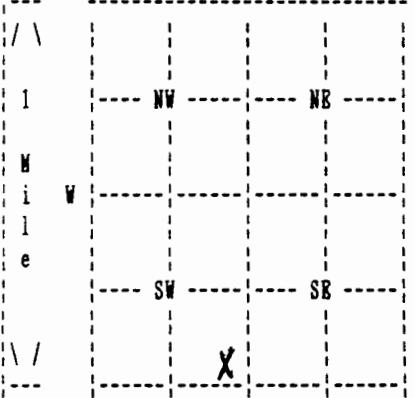

WELL'S STATIC WATER LEVEL 0 ft. below land surface measured on no/day/yr
 Pump test data: Well water was 0 ft. after 0 hours pumping 0 gpm
 Estimated Yield 0 gpm: Well water was 0 ft. after 0 hours pumping 0 gpm
 Bore Hole Diameter in. to 0 ft., and in. to 0 ft.
 WELL WATER WAS: DOMESTIC
 Was a chemical/bacteriological sample submitted to department? No ;
 If yes, no/day/yr sample was submitted Water well disinfected? Yes

5 TYPE OF BLANK CASING USED: RMP (SR) CASING JOINTS: GLUED
 Blank casing diameter 5 in. to 155 ft., Dia in. to 0 ft., Dia in. to 0 ft.
 Casing height above land surface 0 in., weight 0 lbs/ft. Wall thickness or gauge No.
 TYPE OF SCREEN OR PERFORATION MATERIAL: PVC
 SCREEN OR PERFORATION OPENINGS ARE:

SCREEN PERFORATED INTERVALS: From 0 ft. to 0 ft., From 0 ft. to 0 ft.
 From 0 ft. to 0 ft., From 0 ft. to 0 ft.
 GRAVEL PACK INTERVALS: From 0 ft. to 0 ft., From 0 ft. to 0 ft.
 From 0 ft. to 0 ft., From 0 ft. to 0 ft.

6 GROUT MATERIAL BENTONITE
 Grout Intervals: From 0 ft. to 0 ft., From 0 ft. to 0 ft., From 0 ft. to 0 ft.
 What is the nearest source of possible contamination: NONE
 Direction from well? How many feet? 0

FROM	TO	LITHOLOGIC LOG	FROM	TO	PLUGGING INTERVALS
			0	5	TOP SOIL & CLAY
			5	20	BENTONITE GROUT
			20	70	FILL SAND
			70	84	BENTONITE GROUT
			84	155	FILL SAND
			0	0	
			0	0	
			0	0	
			0	0	
			0	0	

7 CONTRACTOR'S OR LANDOWNER'S CERTIFICATION: This water well was plugged under my jurisdiction and was completed on (no/day/year) 09/04/06 and this record is true to the best of my knowledge and belief. Kansas Water Well Contractor's License No. 179 This Water Well Record was completed on (no/day/yr) 09/28/06 under the business name of JOB'S WELL SERVICE, INC. by (signature) *Josaid Crick*