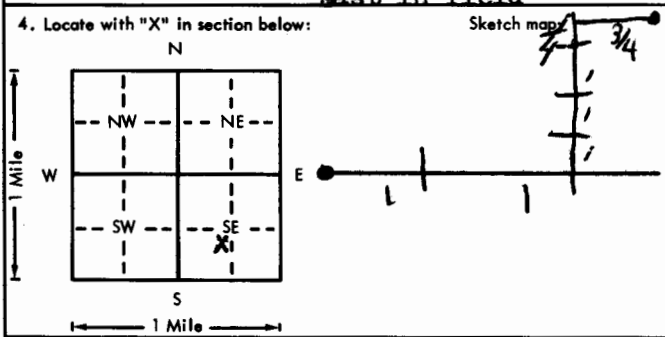


USE TYPEWRITER OR BALL
POINT PEN-PRESS FIRMLY,
PRINT CLEARLY.

WATER WELL RECORD
KSA 82a-1201-1215

Kansas Department of Health and
Environment-Division of Environment
(Water well Contractors)
Topeka, Kansas 66620

1. Location of well:	County Harvey	Fraction NE 1/4 SW 1/4 SE 1/4	Section number 2	Township number T 23	Range number S R 3	E 10
2. Distance and direction from nearest town or city: Street address of well location if in city: 2 mi. east of Burrton, 3 1/4 mi. north, 3/4 East in field			3. Owner of well: Blackstone Drilling Co. R.R. or street: P.O. Box 1184 City, state, zip code: McPherson, Kansas 67460			
4. Locate with "X" in section below: 			6. Bore hole dia. 6 in. Completion date 12/20/78 Well depth 110 ft.			
5. Type and color of material			7. <input type="checkbox"/> Cable tool <input checked="" type="checkbox"/> Rotary <input type="checkbox"/> Driven <input type="checkbox"/> Dug <input type="checkbox"/> Hollow rod <input type="checkbox"/> Jetted <input type="checkbox"/> Bored <input type="checkbox"/> Reverse rotary			
			8. Use: <input type="checkbox"/> Domestic <input type="checkbox"/> Public supply <input type="checkbox"/> Industry <input type="checkbox"/> Irrigation <input type="checkbox"/> Air conditioning <input type="checkbox"/> Stock <input type="checkbox"/> Lawn <input checked="" type="checkbox"/> Oil field water <input type="checkbox"/> Other			
			9. Casing: Material Plastic Height: Above or below Threaded <input type="checkbox"/> Welded <input type="checkbox"/> Surface 18 in. RMP <input type="checkbox"/> PVC <input checked="" type="checkbox"/> Weight 18 lbs./ft. Dia. 3 in. to 90 ft. depth Wall Thickness: inches or Dia. 3 in. to 90 ft. depth gage No. 216			
			10. Screen: Manufacturer's name Certain feed Type sawed Dia. 3 Slot/gauze 1/4 Length 20 Set between 90 ft. and 110 ft. ft. and ft. Gravel pack? yes Size range of material 1/8-1/4			
			11. Static water level: 30' mo./day/yr. 30 ft. below land surface Date 12-20-78			
			12. Pumping level below land surfaces: 35 ft. after 1 hrs. pumping 30 g.p.m. ft. after hrs. pumping g.p.m. Estimated maximum yield 30 g.p.m.			
			13. Water sample submitted: mo./day/yr. Yes <input type="checkbox"/> No <input checked="" type="checkbox"/> Date			
			14. Well head completion: <input type="checkbox"/> Pitless adapter 18 inches above grade			
			15. Well grouted? yes With: <input type="checkbox"/> Neat cement <input checked="" type="checkbox"/> Bentonite <input type="checkbox"/> Concrete Depth: From 0 ft. to 10 ft.			
			16. Nearest source of possible contamination: ft. Direction none Type Well disinfected upon completion? <input type="checkbox"/> Yes <input checked="" type="checkbox"/> No			
			17. Pump: <input checked="" type="checkbox"/> Not installed Manufacturer's name Model number HP Volts Length of drop pipe ft. capacity g.p.m. Type: <input type="checkbox"/> Submersible <input type="checkbox"/> Turbine <input type="checkbox"/> Jet <input type="checkbox"/> Reciprocating <input type="checkbox"/> Centrifugal <input type="checkbox"/> Other			
18. Elevation:			20. Water well contractor's certification: This well was drilled under my jurisdiction and this report is true to the best of my knowledge and belief. Rosenkrantz & Bemis, Inc. Business name License No. 134 Address 1211 W. 4th Hutchinson, Kansas Signed Mike Flowers Date 6-22 Authorized representative			
19. Remarks: Topography: <input type="checkbox"/> Hill <input type="checkbox"/> Slope <input type="checkbox"/> Upland <input type="checkbox"/> Valley						