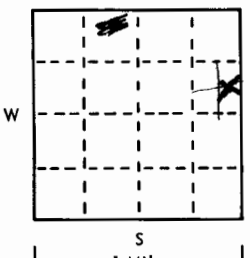
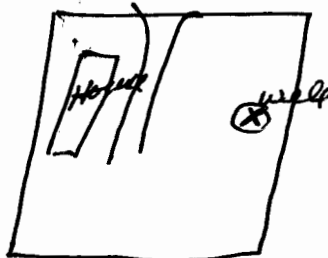


USE TYPEWRITER OR BALL
POINT PEN-PRESS FIRMLY,
PRINT CLEARLY.

WATER WELL RECORD
KSA 82a-1201-1215

T R EW sec 1/4 1/4 1/4 No.

Kansas State Dept. Of Health
(Water Well Contractors)
Forbes-Bldg. 740
Topeka, Kansas 66620

1 Location of well:	County <u>Harvey</u>	Township name <u>Burrton</u>	Fraction <u>SE 1/4 NE 1/4</u>	Section number <u>10</u>	Town number <u>T 23-N</u>	Range number <u>R-3W</u>				
Distance and direction from nearest town or city: <u>2 E - 2 1/2 N 1/2</u>			3 Owner of well: <u>Fred Findley</u>							
Street address of well location if in city: <u>Burrton, Kans.</u>			Address: <u>P.O. Box 376 - R.R. 2 Burrton, Mo.</u>							
Locate with "X" in section below:		Sketch map:		4 Well depth: <u>60</u> ft. Date of completion <u>8-19-75</u> Well diameter <u>8"</u> in.						
				5 <input type="checkbox"/> Cable tool <input checked="" type="checkbox"/> Rotary <input type="checkbox"/> Driven <input type="checkbox"/> Dug <input type="checkbox"/> Hollow rod <input type="checkbox"/> Jetted <input type="checkbox"/> Bored <input type="checkbox"/> Reverse rotary						
2		Type and color of material		From		To		6 Use: <input checked="" type="checkbox"/> Domestic <input type="checkbox"/> Public supply <input type="checkbox"/> Industry <input type="checkbox"/> Irrigation <input type="checkbox"/> Air conditioning <input type="checkbox"/> Commercial <input type="checkbox"/> Test well <input type="checkbox"/>		
								7 Casing: Material <u>P.R.C.</u> Height <u>above</u> /below Threaded <input type="checkbox"/> Welded <input checked="" type="checkbox"/> Surface <u>12</u> in. Diam. <u>5</u> in. to <u>60</u> ft. depth Drive shoe? <input type="checkbox"/> Yes <input checked="" type="checkbox"/> No <u>5</u> in. to <u>60</u> ft. depth		
								8 Screen: Manufacturer <u>Continental</u> Type <u>P.R.C.</u> Dia. <u>5"</u> Slot gauge <u>4/32</u> Length <u>20</u> Set between <u>40</u> ft. and <u>60</u> ft. Fittings: <u>1/2 - 1/4"</u> Gravel pack <input checked="" type="checkbox"/> Yes <input checked="" type="checkbox"/> No Size range of material <u>1/4 - 1/2"</u>		
								9 Static water level: <u>7 1/2</u> ft. below land surface Date <u>8-19-75</u>		
								10 Pumping level below land surfaces: <u>12</u> ft. after <u>2</u> hrs. pumping <u>15</u> g.p.m. <u> </u> ft. after <u> </u> hrs. pumping <u> </u> g.p.m. Estimated maximum yield <u> </u> g.p.m.		
(use a second sheet if needed)								11 Water sample submitted: <input type="checkbox"/> Yes <input checked="" type="checkbox"/> No Date <u> </u>		
								12 Well head completion: <u>12"</u> <input type="checkbox"/> Pitless adapter <input checked="" type="checkbox"/> Inches above grade		
								13 Well grouted? <input checked="" type="checkbox"/> Yes <input type="checkbox"/> No <input checked="" type="checkbox"/> Neat cement <input type="checkbox"/> Bentonite <input type="checkbox"/> Depth: From <u>0</u> ft. to <u>12</u> ft.		
								14 Nearest source of possible contamination: ft. <u>900</u> Direction <u>North</u> Type <u>Septic</u> Well disinfected upon completion? <input checked="" type="checkbox"/> Yes <input type="checkbox"/> No		
								15 Pump: <input checked="" type="checkbox"/> Not installed Manufacturer's name <u> </u> Model number <u> </u> HP <u> </u> Volts <u> </u> Length of drop pipe <u> </u> ft. capacity <u> </u> g.p.m. Type: <input type="checkbox"/> Submersible <input type="checkbox"/> Turbine <input type="checkbox"/> Jet <input type="checkbox"/> Reciprocating <input type="checkbox"/> Centrifugal <input type="checkbox"/> Other		
16 Remarks: elevation		17 Water well contractor's certification:								
<u>surrounding area rolling sand hills</u>		This well was drilled under my jurisdiction and this report is true to the best of my knowledge and belief. <u>Peterson Bros. Inc.</u> <u>138</u> Business name License No. Address <u>Box 150, Leawards, Mo.</u> Signed <u>Wallace Peterson</u> Date <u>8-20-75</u> Authorized representative								