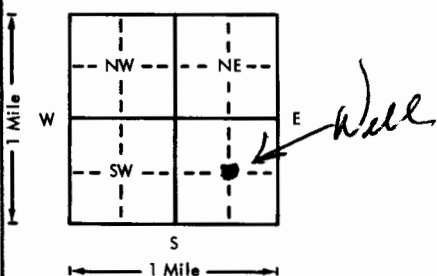


USE TYPEWRITER OR BALL
POINT PEN-PRESS FIRMLY,
PRINT CLEARLY.

WATER WELL RECORD
KSA 82a-1201-1215

Kansas Department of Health and
Environment-Division of Environment
(Water well Contractors)
Topeka, Kansas 66620

1. Location of well:	County <u>Harvey</u>	Fraction <u>Center</u> <u>1/4 of 1/4 SE 1/4</u>	Section number <u>16</u>	Township number T <u>23</u> S	Range number R <u>3</u> W
2. Distance and direction from nearest town or city:	3. Owner of well: <u>CLAYTON KAUFFMAN</u>		R.R. or street: <u>401 NORMANDY RD.</u>		
Street address of well location if in city: <u>2 NO - 1 East of Burton, Kans</u>		City, state, zip code: <u>NEWTON KANSAS</u>			
4. Locate with "X" in section below:		Sketch map:		6. Bore hole dia. <u>30</u> in. Completion date <u>8-10</u> Well depth <u>76</u> ft.	
				7. <input type="checkbox"/> Cable tool <input type="checkbox"/> Rotary <input type="checkbox"/> Driven <input type="checkbox"/> Dug <input type="checkbox"/> Hollow rod <input type="checkbox"/> Jetted <input checked="" type="checkbox"/> Bored <input type="checkbox"/> Reverse rotary	
5. Type and color of material		From	To	8. Use: <input type="checkbox"/> Domestic <input type="checkbox"/> Public supply <input type="checkbox"/> Industry <input checked="" type="checkbox"/> Irrigation <input type="checkbox"/> Air conditioning <input type="checkbox"/> Stock <input type="checkbox"/> Lawn <input type="checkbox"/> Oil field water <input type="checkbox"/> Other	
<u>Top soil</u>		<u>0</u>	<u>2</u>	9. Casing: Material <u>TRANSIT</u> Height: <u>Above</u> or <u>Below</u> Threaded <input type="checkbox"/> Welded <input type="checkbox"/> Surface <u>72</u> in. RMP <input type="checkbox"/> PVC <input type="checkbox"/> Weight <u>34</u> lbs./ft. Dia <u>16</u> in. to <u>195</u> ft. depth Wall Thickness: inches or Dia. <u>16</u> in. to <u>195</u> ft. depth gage No. <u>344</u>	
<u>Clay - Red</u>		<u>2</u>	<u>12</u>	10. Screen: Manufacturer's name <u>AURORA TILE CO</u> Type <u>TRANSIT</u> Dia. <u>16" I.P.</u> Slot/gauze <u>1/8</u> Length <u>72</u> Set between <u>143</u> ft. and <u>195</u> ft. ft. and <u>195</u> ft. Gravel pack? <u>Yes</u> Size range of material <u>1/4"</u>	
<u>SAND - FINE</u>		<u>12</u>	<u>22</u>	11. Static water level: <u>22</u> ft. below land surface Date <u>8-10-71</u> mo./day/yr.	
<u>Clay Red</u>		<u>22</u>	<u>38</u>	12. Pumping level below land surfaces: <u>55</u> ft. after <u>2</u> hrs. pumping <u>800</u> g.p.m. ft. after <u> </u> hrs. pumping <u> </u> g.p.m. Estimated maximum yield <u>1000</u> g.p.m.	
<u>SAND - med. to coarse</u>		<u>38</u>	<u>55</u>	13. Water sample submitted: <u> </u> mo./day/yr. Yes <input type="checkbox"/> No <input checked="" type="checkbox"/> Date <u> </u>	
<u>Clay - Blue</u>		<u>55</u>	<u>103</u>	14. Well head completion: <u> </u> Pitless adapter <u>12</u> inches above grade	
<u>Clay - Layers of fine sand</u>		<u>103</u>	<u>133</u>	15. Well grouted? <u>Yes</u> <u>Buddled clay</u> With: <u> </u> Neat cement <u> </u> Bentonite <u> </u> Concrete Depth: From <u>0</u> ft. to <u>10</u> ft.	
<u>SAND - med. to fine</u>		<u>133</u>	<u>194</u>	16. Nearest source of possible contamination: ft. <u>2000</u> Direction <u>W</u> Type <u>well</u> Well disinfected upon completion? <u> </u> Yes <input checked="" type="checkbox"/> No <input type="checkbox"/>	
<u>SHALE - Green</u>		<u>194</u>	<u>195</u>	17. Pump: <u> </u> Not installed Manufacturer's name <u>WESTERN HAND COLLECTOR</u> Model number <u>80m</u> HP <u> </u> Volts <u> </u> Length of drop pipe <u>110</u> ft. capacity <u> </u> g.p.m. Type: <input type="checkbox"/> Submersible <input checked="" type="checkbox"/> Turbine <input type="checkbox"/> Jet <input type="checkbox"/> Reciprocating <input type="checkbox"/> Centrifugal <input type="checkbox"/> Other	
(Use a second sheet if needed)					
18. Elevation:	19. Remarks:		20. Water well contractor's certification: This well was drilled under my jurisdiction and this report is true to the best of my knowledge and belief. <u>PETERSON TRAVELER INC</u> License No. <u>138A</u> Business name <u> </u> License No. <u> </u> Address <u>Box 150 LINDSAY, KS</u> Signed <u>William Peterson</u> Date <u>8-4</u> Authorized representative <u> </u> <u>77</u>		
Topography: <input type="checkbox"/> Hill <input type="checkbox"/> Slope <input type="checkbox"/> Upland <input checked="" type="checkbox"/> Valley					