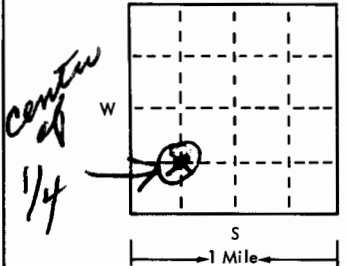


USE TYPEWRITER OR BALL
POINT PEN-PRESS FIRMLY,
PRINT CLEARLY.

WATER WELL RECORD
KSA 82a-1201-1215

T R EW sec 1/4 1/4 1/4 No.

Kansas State Dept. Of Health
(Water Well Contractors)
Forbes-Bldg. 740
Topeka, Kansas 66620

1 Location of well:	County HARVEY	Township name BURTON	Fraction SW 1/4	Section number 18	Town number T5 23	Range number 3-W
Distance and direction from nearest town or city: 2 miles N.E. OF BURTON, KANS			3 Owner of well: JIM STEINENS Address: RR II BURTON KANS			
Locate with "X" in section below: N Sketch map: 			4 Well depth: 169 ft. Date of completion 10-23-75 Well diameter 30 in.			
2			5 <input type="checkbox"/> Cable tool <input type="checkbox"/> Rotary <input type="checkbox"/> Driven <input type="checkbox"/> Dug <input type="checkbox"/> Hollow rod <input type="checkbox"/> Jetted <input type="checkbox"/> Bored <input checked="" type="checkbox"/> Reverse rotary			
			6 Use: <input type="checkbox"/> Domestic <input type="checkbox"/> Public supply <input type="checkbox"/> Industry <input checked="" type="checkbox"/> Irrigation <input type="checkbox"/> Air conditioning <input type="checkbox"/> Commercial <input type="checkbox"/> Test well			
			7 Casing: Material WELDED Height: above/below Threaded <input type="checkbox"/> Welded <input type="checkbox"/> Surface 14 in. Diam. 16 in. to 169 ft. depth Drive shoe? <input type="checkbox"/> Yes <input checked="" type="checkbox"/> No			
			8 Screen: AUGERED TILE GR Manufacturer TRANSITE Dia. 16" I.D. Slot/gauze 1/8 Length 52" Set between 117 ft. and 169 ft. Fittings: Gravel pack <input checked="" type="checkbox"/> Yes <input type="checkbox"/> No Size range of material #1			
Type and color of material			From	To	9 Static water level: 24 ft. below land surface Date 10-23-75	
Top - soil			0	2	10 Pumping level below land surfaces: ____ ft. after ____ hrs. pumping ____ g.p.m. ____ ft. after ____ hrs. pumping ____ g.p.m. Estimated maximum yield 1500 g.p.m.	
Clay - Red			2	7	11 Water sample submitted: <input type="checkbox"/> Yes <input checked="" type="checkbox"/> No Date ____	
Gravel			7	12	12 Well head completion: <input type="checkbox"/> Pitless adapter <input type="checkbox"/> Inches above grade	
Clay - Buff			12	48	13 Well grouted? <input checked="" type="checkbox"/> Yes <input type="checkbox"/> No <input type="checkbox"/> Neat cement <input type="checkbox"/> Bentonite <input checked="" type="checkbox"/> Clay Depth: From 2 ft. to 10 ft.	
Gravel			48	65	14 Nearest source of possible contamination: ft. 1000 Direction N.W. Type well Well disinfected upon completion? <input type="checkbox"/> Yes <input checked="" type="checkbox"/> No	
Clay - Buff			65	88	15 Pump: <input type="checkbox"/> Not installed Manufacturer's name WESTERN LUB POLAR Model number 81M HP 60 Volts Length of drop pipe 110 ft. capacity 1500 g.p.m. Type: <input type="checkbox"/> Submersible <input checked="" type="checkbox"/> Turbine <input type="checkbox"/> Jet <input type="checkbox"/> Reciprocating <input type="checkbox"/> Centrifugal <input type="checkbox"/> Other	
SAND - Very Fine			88	106	16 Remarks: elevation Topography: FLAT LAND SANDY LOAM <input type="checkbox"/> Hill <input type="checkbox"/> Slope <input type="checkbox"/> Upland <input type="checkbox"/> Valley	
SAND + CLAY MIXED			106	124	17 Water well contractor's certification: This well was drilled under my jurisdiction and this report is true to the best of my knowledge and belief. Peterson Bros Inc License No. 138 Business name Box 150 Lincolnton Kans Address Wellman Peterson Date 10-23-75 Signed Wellman Peterson Authorized representative	
Gravel - medium			124	169		
Gravel - Fine -			169	171		
Very good water loss						
Cased 169 ft.						