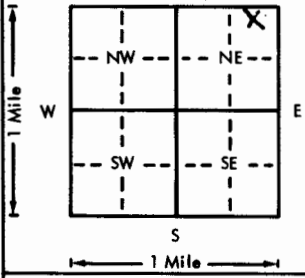
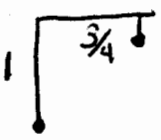


USE TYPEWRITER OR BALL
POINT PEN—PRESS FIRMLY,
PRINT CLEARLY.

WATER WELL RECORD
KSA 82a-1201-1215

Kansas Department of Health and
Environment—Division of Environment
(Water well Contractors)
Topeka, Kansas 66620

1. Location of well:	County Harvey	Fraction NE 1/4 NE 1/4 NE 1/4	Section number 21	Township number T 23 S	Range number R 3 E																				
2. Distance and direction from nearest town or city: 1 mi. north of Burrton, 3/4 mi. east on south side			3. Owner of well: Blackstone Drilling Co. R.R. or street P.O. Box 1184 City, state, zip code McPherson, Kansas 67460																						
4. Locate with "X" in section below: N  S W E 1 Mile			Sketch map: 																						
5. Type and color of material			6. Bore hole dia. 6 in. Completion date 4/28/78 Well depth 30 ft.																						
			7. Cable tool <input checked="" type="checkbox"/> Rotary <input type="checkbox"/> Driven <input type="checkbox"/> Dug <input type="checkbox"/> Hollow rod <input type="checkbox"/> Jetted <input type="checkbox"/> Bored <input type="checkbox"/> Reverse rotary																						
<table border="1" style="width:100%; border-collapse: collapse;"> <tr> <td style="width:50%;">Top soil and black clay</td> <td style="width:10%;">From</td> <td style="width:10%;">To</td> <td style="width:30%;"></td> </tr> <tr> <td>Clay & Med. sand</td> <td>5</td> <td>10</td> <td></td> </tr> <tr> <td>Med. sand</td> <td>10</td> <td>20</td> <td></td> </tr> <tr> <td>Fine sand & hard clay</td> <td>20</td> <td>27</td> <td></td> </tr> <tr> <td>Med. fine sand</td> <td>27</td> <td>30</td> <td></td> </tr> </table>			Top soil and black clay	From	To		Clay & Med. sand	5	10		Med. sand	10	20		Fine sand & hard clay	20	27		Med. fine sand	27	30		8. Use: <input type="checkbox"/> Domestic <input type="checkbox"/> Public supply <input type="checkbox"/> Industry <input type="checkbox"/> Irrigation <input type="checkbox"/> Air conditioning <input type="checkbox"/> Stock <input type="checkbox"/> Lawn <input checked="" type="checkbox"/> Oil field water <input type="checkbox"/> Other		
			Top soil and black clay	From	To																				
Clay & Med. sand	5	10																							
Med. sand	10	20																							
Fine sand & hard clay	20	27																							
Med. fine sand	27	30																							
			9. Casing: Material Plastic Height: Above or below Threaded <input type="checkbox"/> Welded <input type="checkbox"/> Surface 18 in. RMP <input type="checkbox"/> PVC <input checked="" type="checkbox"/> Weight 10 lbs./ft. Dia. 3 in. to 10 ft. depth Wall Thickness: inches or Dia. 3 in. to 10 ft. depth gage No. 216																						
			10. Screen: Manufacturer's name Certain feed Type Sawed Dia. 3 Slot/gauze 1/4 Length 20 Set between 10 ft. and 30 ft. ft. and 1/2 ft. Gravel pack yes Size range of material 1/8 x 1/4																						
			11. Static water level: 15 ft. below land surface Date 4/28/78 mo./day/yr.																						
			12. Pumping level below land surfaces: 18 ft. after 1 hrs. pumping 80 g.p.m. ft. after 1 hrs. pumping 80 g.p.m. Estimated maximum yield 80 g.p.m.																						
			13. Water sample submitted: Yes <input checked="" type="checkbox"/> No <input type="checkbox"/> Date																						
			14. Well head completion: 18 inches above grade Pitless adapter																						
			15. Well grouted? Yes With: <input checked="" type="checkbox"/> Neat cement <input checked="" type="checkbox"/> Bentonite <input checked="" type="checkbox"/> Concrete 1/4 Depth: From 0 ft. to 10 ft.																						
			16. Nearest source of possible contamination: ft. Direction none Type none Well disinfected upon completion? Yes <input checked="" type="checkbox"/> No <input type="checkbox"/>																						
			17. Pump: <input checked="" type="checkbox"/> Not installed Manufacturer's name Model number HP Volts Length of drop pipe ft. capacity g.p.m. Type: <input type="checkbox"/> Submersible <input type="checkbox"/> Turbine <input type="checkbox"/> Jet <input type="checkbox"/> Reciprocating <input type="checkbox"/> Centrifugal <input type="checkbox"/> Other																						
			20. Water well contractor's certification: This well was drilled under my jurisdiction and this report is true to the best of my knowledge and belief. Darling Drilling Co. 189 Business name License No. Address 1211 W. 4th, Hutchinson, Kansas Signed Mike F. Davis Date 6-17-78 Authorized representative																						
18. Elevation:		19. Remarks:																							
Topography: <input type="checkbox"/> Hill <input type="checkbox"/> Slope <input checked="" type="checkbox"/> Upland <input type="checkbox"/> Valley																									

23-30-21 NE NE NE
1/4 1/4 1/4