

|                           |        |                      |                |                 |              |
|---------------------------|--------|----------------------|----------------|-----------------|--------------|
| 1 LOCATION OF WATER WELL: |        | Fraction             | Section Number | Township Number | Range Number |
| County:                   | HARVEY | SE 1/4 NE 1/4 NW 1/4 | 21             | T 23 S          | R 3 E        |


Distance and direction from nearest town or city street address of well if located within city?  
1 mi. N. AND  $\frac{1}{2}$  mi. EAST of BURRTON, Ks.

|                           |                                     |                                                   |
|---------------------------|-------------------------------------|---------------------------------------------------|
| 2                         | WATER WELL OWNER: <u>John Weber</u> | 1                                                 |
| RR#, St. Address, Box # : | <u>RR. 1</u>                        | Board of Agriculture, Division of Water Resources |
| City, State, ZIP Code :   | <u>Halstead, KS. 67056</u>          | Application Number:                               |

3 LOCATE WELL'S LOCATION WITH AN "X" IN SECTION BOX: 4 DEPTH OF COMPLETED WELL: 170 ft. ELEVATION: \_\_\_\_\_

N

Depth(s) Groundwater Encountered 1. \_\_\_\_\_ ft. 2. \_\_\_\_\_ ft. 3. \_\_\_\_\_ ft.

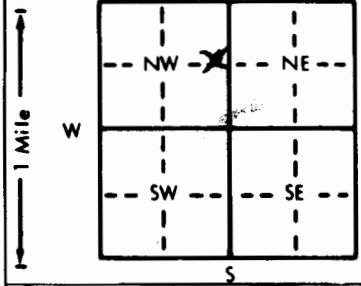

WELL'S STATIC WATER LEVEL ..... 4 ..... ft. below land surface measured on mo/day/yr .....

Pump test data: Well water was ..... ft. after ..... hours pumping ..... gpm

Est. Yield ..... gpm: Well water was ..... ft. after ..... hours pumping ..... gpm

Bore Hole Diameter 30 ..... in. to 170 ..... ft., and ..... in. to ..... ft.

WELL WATER TO BE USED AS:

|                     |              |                          |                    |                          |
|---------------------|--------------|--------------------------|--------------------|--------------------------|
| 1 Domestic          | 3 Feedlot    | 6 Oil field water supply | 9 Dewatering       | 11 Injection well        |
| <u>2 Irrigation</u> | 4 Industrial | 7 Lawn and garden only   | 10 Monitoring well | 12 Other (Specify below) |

Was a chemical/bacteriological sample submitted to Department? Yes.....No.....; If yes, mo/day/yr sample was submitted

Water Well Disinfected? Yes No

|   |                            |            |                   |                         |                                                                      |
|---|----------------------------|------------|-------------------|-------------------------|----------------------------------------------------------------------|
| 5 | TYPE OF BLANK CASING USED: |            | 5 Wrought iron    | 8 Concrete tile         | CASING JOINTS: Glued . . . . . Clamped . . . . .<br>Welded . . . . . |
|   | 1 Steel                    | 3 RMP (SR) | 6 Asbestos-Cement | 9 Other (specify below) |                                                                      |

| 2 PVC                 |        | 4 ABS    |        | 7 Fiberglass |        | Threaded |  |
|-----------------------|--------|----------|--------|--------------|--------|----------|--|
| Blank casing diameter | in. to | ft., Dia | in. to | ft., Dia     | in. to | ft.      |  |

Casing height above land surface.....in., weight.....lbs./ft. Wall thickness or gauge No. ....

TYPE OF SCREEN OR PERFORATION MATERIAL: 7 PVC 10 Asbestos-cement

|         |                    |                 |            |                              |
|---------|--------------------|-----------------|------------|------------------------------|
| 1 Steel | 3 Stainless steel  | 5 Fiberglass    | 8 RMP (SR) | 11 Other (specify) . . . . . |
| 2 Brass | 4 Galvanized steel | 6 Concrete tile | 9 ABS      | 12 None used (open hole)     |

|                                     |             |                  |                 |                     |
|-------------------------------------|-------------|------------------|-----------------|---------------------|
| SCREEN OR PERFORATION OPENINGS ARE: |             | 5 Gauzed wrapped | 8 Saw cut       | 11 None (open hole) |
| 1 Continuous slot                   | 3 Mill slot | 6 Wire wrapped   | 9 Drilled holes |                     |

2 Louvered shutter      4 Key punched      7 Torch cut      10 Other (specify) .....

SCREEN-PERFORATED INTERVALS: From ..... ft. to ..... ft., From ..... ft. to ..... ft.

|                        |                |                  |                    |                  |     |
|------------------------|----------------|------------------|--------------------|------------------|-----|
|                        | From . . . . . | ft. to . . . . . | ft. From . . . . . | ft. to . . . . . | ft. |
| GRAVEL PACK INTERVALS: | From . . . . . | ft. to . . . . . | ft. From . . . . . | ft. to . . . . . | ft. |

|   |                 | From          |                | ft. to      |         | ft., From |  | ft. to |  | ft. |  |
|---|-----------------|---------------|----------------|-------------|---------|-----------|--|--------|--|-----|--|
| 6 | GROUT MATERIAL: | 1 Neat cement | 2 Cement grout | 3 Bentonite | 4 Other |           |  |        |  |     |  |

Grout Intervals: From ..... ft. to ..... ft., From ..... ft. to ..... ft., From ..... ft. to ..... ft.  
What is the nearest source of possible contamination: 10 Livestock pens 14 Abandoned water well

|               |                 |                 |                       |                          |
|---------------|-----------------|-----------------|-----------------------|--------------------------|
| 1 Septic tank | 4 Lateral lines | 7 Pit privy     | 11 Fuel storage       | 15 Oil well/Gas well     |
| 2 Sewer lines | 5 Cess pool     | 8 Sewage lagoon | 12 Fertilizer storage | 16 Other (specify below) |

|                          |               |            |                        |
|--------------------------|---------------|------------|------------------------|
| 3 Watertight sewer lines | 6 Seepage pit | 9 Feedyard | 13 Insecticide storage |
| Direction from well?     |               |            | How many feet?         |

[illegible]

7. CONTRACTOR'S OR LANDOWNER'S CERTIFICATION: This water well was (1) constructed, (2) reconstructed, or (3) plugged under my jurisdiction and was completed on (mo/day/year) 3-21-94 and this record is true to the best of my knowledge and belief. Kansas

Water Well Contractor's License No. 138 This Water Well Record was completed on (mo/day/yr) 4-9-94  
under the business name of PETERSEN TAP by (signature) M. K. Petersen

INSTRUCTIONS: Use typewriter or ball point pen. PLEASE PRESS FIRMLY and PRINT clearly. Please fill in blanks, underline or circle the correct answers. Send top three copies to Kansas Department of Health and Environment, Bureau of Water, Topeka, Kansas 66620-0001. Telephone: 913-296-5545. Send one to WATER WELL OWNER and retain one for your records.