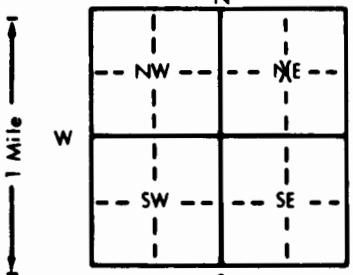


1 LOCATION OF WATER WELL: County: HARVEY	Fraction $\frac{1}{4}$ NW $\frac{1}{4}$ NE $\frac{1}{4}$	Section Number 21	Township Number T 23 S	Range Number R 3 E/W
---	--	-------------------	------------------------	----------------------

Distance and direction from nearest town or city street address of well if located within city?

3/4 MILE NORTH AND 3/4 MILE EAST OF BURRTON, KS

2 WATER WELL OWNER: JOHN WEBER RR#, St. Address, Box #: RR 1 City, State, ZIP Code: HALSTEAD, KS 67056	Board of Agriculture, Division of Water Resources Application Number: 38979
--	--

3 LOCATE WELL'S LOCATION WITH AN "X" IN SECTION BOX: 	4 DEPTH OF COMPLETED WELL: 150 ft. ELEVATION: Depth(s) Groundwater Encountered 1. ft. 2. ft. 3. ft. WELL'S STATIC WATER LEVEL 30 ft. below land surface measured on mo/day/yr ESTIMATED Pump test data: Well water was ft. after hours pumping gpm Est. Yield gpm: Well water was ft. after hours pumping gpm Bore Hole Diameter 30 in. to 150 ft., and in. to ft. WELL WATER TO BE USED AS: 1 Domestic 3 Feedlot 6 Oil field water supply 9 Dewatering 12 Other (Specify below) 2 Irrigation 4 Industrial 7 Lawn and garden only 10 Monitoring well Was a chemical/bacteriological sample submitted to Department? Yes No X; If yes, mo/day/yr sample was submitted Water Well Disinfected? Yes No X
--	---

5 TYPE OF BLANK CASING USED: 1 Steel 3 RMP (SR) 5 Wrought iron 8 Concrete tile 2 PVC 4 ABS 6 Asbestos-Cement 9 Other (specify below) 3 5/8 in. to 150 ft., Dia. in. to ft., Dia. in. to ft. Casing height above land surface 36 in., weight lbs./ft. Wall thickness or gauge No.	CASING JOINTS: Glued Clamped Welded Threaded
TYPE OF SCREEN OR PERFORATION MATERIAL: 1 Steel 3 Stainless steel 5 Fiberglass 8 RMP (SR) 2 Brass 4 Galvanized steel 6 Concrete tile 9 ABS	10 Asbestos-cement 11 Other (specify) N/A 12 None used (open hole)
SCREEN OR PERFORATION OPENINGS ARE: 1 Continuous slot 3 Mill slot 5 Gauzed wrapped 8 Saw cut 2 Louvered shutter 4 Key punched 6 Wire wrapped 9 Drilled holes 7 Torch cut 10 Other (specify) N/A	11 None (open hole)
SCREEN-PERFORATED INTERVALS: From N/A ft. to ft. From ft. to ft. From ft. to ft. From ft. to ft.	
GRAVEL PACK INTERVALS: From N/A ft. to ft. From ft. to ft. From ft. to ft. From ft. to ft.	

6 GROUT MATERIAL: 1 Neat cement 2 Cement grout 3 Bentonite 4 Other Grout Intervals: From 150 ft. to 3 ft. From ft. to ft. From ft. to ft.	
What is the nearest source of possible contamination: 1 Septic tank 4 Lateral lines 7 Pit privy 10 Livestock pens 14 Abandoned water well 2 Sewer lines 5 Cess pool 8 Sewage lagoon 11 Fuel storage 15 Oil well/Gas well 3 Watertight sewer lines 6 Seepage pit 9 Feedyard 12 Fertilizer storage 16 Other (specify below) 13 Insecticide storage	
Direction from well? NORTHWEST	How many feet? 800

FROM	TO	LITHOLOGIC LOG	FROM	TO	PLUGGING INTERVALS
		DRILL STEM AND BIT STUCK IN HOLE AFTER CAVE-IN	150	3	BENSEAL BENTONITE GROUT PUMPED INSIDE DRILL STEM BOTTOM TO TOP
		NO CASING	13	4	4 FT. DIAMETER AROUND DRILL STEM PLUGGED WITH CEMENT GROUT
		TOP OF DRILL STEM IS AT 3 FT. BELOW LAND SURFACE	3	0	TOPSOIL

7 CONTRACTOR'S OR LANDOWNER'S CERTIFICATION: This water well was (1) constructed, (2) reconstructed, or (3) plugged under my jurisdiction and was completed on (mo/day/year) 3/17/94 and this record is true to the best of my knowledge and belief. Kansas Water Well Contractor's License No. 138 This Water Well Record was completed on (mo/day/yr) 6-22-94 under the business name of PETERSON IRRIGATION by (signature) Mike Peterson
