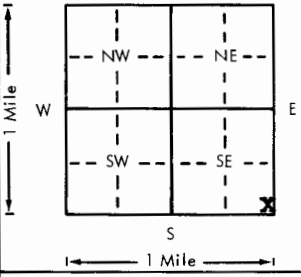


USE TYPEWRITER OR BALL
POINT PEN-PRESS FIRMLY,
PRINT CLEARLY.

WATER WELL RECORD
KSA 82a-1201-1215

Kansas Department of Health and
Environment-Division of Environment
(Water well Contractors)
Topeka, Kansas 66620

1. Location of well:		County Harvey	Fraction SE 1/4 SE 1/4 SE 1/4	Section number 34	Township number T 23 S	Range number R 3 E/W
2. Distance and direction from nearest town or city: 3 miles southeast of Burrton Street address of well location if in city:				3. Owner of well: Equus Beds GMD R.R. or street: Box 232 City, state, zip code: Halstead, Ks 67056		
4. Locate with "X" in section below: N 1 Mile W E S 1 Mile Sketch map:				6. Bore hole dia. 4 in. Completion date 8/4/78 Well depth 125 ft.		
				7. <input type="checkbox"/> Cable tool <input checked="" type="checkbox"/> Rotary <input type="checkbox"/> Driven <input type="checkbox"/> Dug <input type="checkbox"/> Hollow rod <input type="checkbox"/> Jetted <input type="checkbox"/> Bored <input type="checkbox"/> Reverse rotary		
				8. Use: <input type="checkbox"/> Domestic <input type="checkbox"/> Public supply <input type="checkbox"/> Industry <input type="checkbox"/> Irrigation <input type="checkbox"/> Air conditioning <input type="checkbox"/> Stock <input type="checkbox"/> Lawn <input type="checkbox"/> Oil field water <input checked="" type="checkbox"/> Other		
5. Type and color of material				From	To	9. Casing: Material <input type="checkbox"/> Threaded <input type="checkbox"/> Welded <input type="checkbox"/> Surface 2.17 ft. in. RMP 2 122 <input checked="" type="checkbox"/> PVC <input type="checkbox"/> Weight <input type="checkbox"/> lbs./ft. Dia. <input type="checkbox"/> in. to <input type="checkbox"/> ft. depth Wall thickness: inches or Dia. <input type="checkbox"/> in. to <input type="checkbox"/> ft. depth gage No. Sch 40
Top soil				0	4	10. Screen: Manufacturer's name Johnson Type wellpoint 1.25 in. Slot/gauze 10 Length 36 in. Set between 122 ft. and 125 ft. Gravel pack? no Size range of material
Clay, gray				4	11	11. Static water level: 18.53 ft. below land surface Date 8/28/78 mo./day/yr.
Sand & gravel, rust				11	29	12. Pumping level below land surfaces: ft. after hrs. pumping g.p.m. ft. after hrs. pumping g.p.m. Estimated maximum yield g.p.m.
Clay, gray				29	31	13. Water sample submitted: <input type="checkbox"/> Yes <input checked="" type="checkbox"/> No Date
Sand & gravel, red, white				31	40	14. Well head completion: <input type="checkbox"/> Pitless adapter <input type="checkbox"/> Inches above grade
Clay, green				40	46	<input checked="" type="checkbox"/> Well grouted? yes With: <input type="checkbox"/> Neat cement <input type="checkbox"/> Bentonite <input checked="" type="checkbox"/> Concrete Depth: From 0 ft. to 2 ft.
Sand & gravel, white				46	65	16. Nearest source of possible contamination: ft. Direction Type Well disinfected upon completion? <input type="checkbox"/> Yes <input checked="" type="checkbox"/> No
Clay, green, gray, tan				65	95	17. Pump: <input checked="" type="checkbox"/> Not installed Manufacturer's name Model number HP Volts Length of drop pipe ft. capacity g.p.m. Type: <input type="checkbox"/> Submersible <input type="checkbox"/> Turbine <input type="checkbox"/> Jet <input type="checkbox"/> Reciprocating <input type="checkbox"/> Centrifugal <input type="checkbox"/> Other
Sand & gravel, yellow, white				95	125	20. Water well contractor's certification: This well was drilled under my jurisdiction and this report is true to the best of my knowledge and belief. Equus Beds GMD Business name License No. Address Box 232, Halstead, Ks Signed Thomas C. Sell Date 1/16/79 Authorized representative
Clay, green				125	128	
Fine sand, greenish white				128	154	
Fine sand & clay, layers, green				154	160	
Clay, gray, tan				160	195	
(Use a second sheet if needed)						
18. Elevation: 1438 ft. Topography: <input type="checkbox"/> Hill <input type="checkbox"/> Slope <input type="checkbox"/> Upland <input type="checkbox"/> Valley		19. Remarks: EB - 14B				