

1 LOCATION OF WATER WELL: County: Harvey Fraction NE 1/4 SE 1/4 SE 1/4 Section Number 34 Township Number T 23 S Range Number R 3 E

Distance and direction from nearest town or city street address of well if located within city?

2 mi. E, 1 1/4 S of Burton on S Sand Hill Rd


2 WATER WELL OWNER: John Grey
RR#, St. Address, Box #: 914 N Burmac Rd
City, State, ZIP Code: Burton, KS 67020

Board of Agriculture, Division of Water Resources

Application Number:

3 LOCATE WELL'S LOCATION WITH AN "X" IN SECTION BOX:

4 DEPTH OF COMPLETED WELL: 40 ft. ELEVATION:

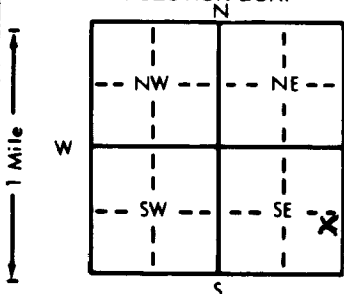

Depth(s) Groundwater Encountered 1. ft. 2. ft. 3. ft.

WELL'S STATIC WATER LEVEL 16 ft. below land surface measured on mo/day/yr 5-5-99

Pump test data: Well water was 17 ft. after 1/2 hours pumping 25 gpm

Est. Yield gpm: Well water was ft. after hours pumping gpm

Bore Hole Diameter 8 in. to 42 ft. and in. to ft.

WELL WATER TO BE USED AS: 5 Public water supply 8 Air conditioning 11 Injection well
☒ Domestic 3 Feedlot 6 Oil field water supply 9 Dewatering 12 Other (Specify below)
 2 Irrigation 4 Industrial 7 Lawn and garden only 10 Monitoring well

Was a chemical/bacteriological sample submitted to Department? Yes No X If yes, mo/day/yr sample was sub

mitted

Water Well Disinfected? Yes X No

5 TYPE OF BLANK CASING USED:

5 Wrought iron

8 Concrete tile

CASING JOINTS: Glued X Clamped

1 Steel

3 RMP (SR)

6 Asbestos-Cement

9 Other (specify below)

Welded

☒ PVC

4 ABS

7 Fiberglass

Threaded

Blank casing diameter 5 in. to 30 ft. Dia. in. to ft. Dia. in. to ft.

Casing height above land surface 12 in. weight 2.29 lbs./ft. Wall thickness or gauge No. 160

TYPE OF SCREEN OR PERFORATION MATERIAL:

1 Steel

3 Stainless steel

5 Fiberglass

☒ PVC

10 Asbestos-cement

2 Brass

4 Galvanized steel

6 Concrete tile

8 RMP (SR)

11 Other (specify)

9 ABS

12 None used (open hole)

SCREEN OR PERFORATION OPENINGS ARE:

1 Continuous slot

3 Mill slot

5 Gauzed wrapped

☒ Saw cut

11 None (open hole)

2 Louvered shutter

4 Key punched

6 Wire wrapped

9 Drilled holes

3 Mill slot

7 Torch cut

10 Other (specify)

SCREEN-PERFORATED INTERVALS:

From 30 ft. to 40 ft. From ft. to ft.

From ft. to ft. From ft. to ft.

GRAVEL PACK INTERVALS: From 23 ft. to 42 ft. From ft. to ft.

From ft. to ft. From ft. to ft.

6 GROUT MATERIAL:

1 Neat cement

2 Cement grout

☒ Bentonite

4 Other

Grout intervals: From 3 ft. to 23 ft. From ft. to ft. From ft. to ft.

What is the nearest source of possible contamination:

1 Septic tank

4 Lateral lines

7 Pit privy

10 Livestock pens

14 Abandoned water well

2 Sewer lines

5 Cess pool

☒ Sewage lagoon

11 Fuel storage

15 Oil well/Gas well

3 Watertight sewer lines

6 Seepage pit

9 Feedyard

12 Fertilizer storage

16 Other (specify below)

13 Insecticide storage

Direction from well? N

How many feet? 125

FROM TO LITHOLOGIC LOG FROM TO PLUGGING INTERVALS

0 8 Br + Gr Clay
 8 41 Sand + Gravel
 41 42 Br Clay

7 CONTRACTOR'S OR LANDOWNER'S CERTIFICATION: This water well was ☒ constructed, (2) reconstructed, or (3) plugged under my jurisdiction and was completed on (mo/day/year) 5-5-99 and this record is true to the best of my knowledge and belief. Kansas

Water Well Contractor's License No. 447 This Water Well Record was completed on (mo/day/yr) 5-8-99

under the business name of Miller Drilling by (signature) E. Miller