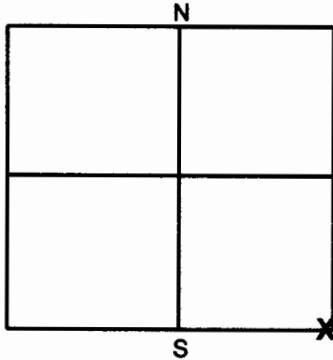


LOCATION OF WATER WELL: HARVEY	Fraction SE 1/4 SE 1/4 SE 1/4	Section Number 34	Township Number 23	Range Number 3W
-----------------------------------	----------------------------------	----------------------	-----------------------	--------------------

Distance and direction from nearest town or city street address of well if located within city?

51' WEST & 33' NORTH OF SAND HILL RD & SW 36TH INTERSECTION

WATER WELL OWNER: RR#, St. Address, Box #: City, State, ZIP Code:	Equus Beds Groundwater Management District No. 2 313 Spruce Street Halstead, Kansas 67056	Board of Agriculture, Division of Water Resources Application Number: NOT APPLICABLE
-------------------------------------------------------------------------	---	-----------------------------------------------------------------------------------------

MARK WELL'S LOCATION WITH
AN "X" IN SECTION BOX

DEPTH OF WELL 125 ft.

WELL'S STATIC WATER LEVEL 20.2 ft.

WELL WAS USED AS:

- | | | |
|--------------|--------------------------|----------------------------|
| 1 Domestic | 5 Public Water Supply | 9 Dewatering |
| 2 Irrigation | 6 Oil Field Water Supply | 10 Monitoring Well - EB14B |
| 3 Feedlot | 7 Lawn and Garden Only | 11 Injection Well |
| 4 Industrial | 8 Air Conditioning | 12 Other |

Was a chemical/bacteriological sample submitted to Department? Yes ☐ No X

If yes, mo/day/yr sample was submitted: / /

WaterWell Disinfected: Yes ☐ No X

TYPE OF BLANK CASING USED:

- | | | | | |
|---------|------------|-------------------|-----------------|---------|
| 1 Steel | 3 RMP (SR) | 5 Wrought | 7 Fiberglass | 9 Other |
| 2 PVC | 4 ABS | 6 Asbestos-Cement | 8 Concrete Tile | |

Blank casing diameter 2 in. Was casing pulled? Yes ☐ No X if yes, how much

Casing height above or below land surface 36 in.

GROUT PLUG MATERIAL: 1 Neat cement 2 Cement grout 3 Bentonite 4 Other

Grout Plug Intervals: From 125 ft. to 3 ft., From ft. to ft., From ft. to ft.

What is the nearest source of possible contamination:

- | | | | |
|--------------------------|-------------------|-------------------------|----------|
| 1 Septic tank | 6 Seepage pit | 11 Fuel Storage | 16 Other |
| 2 Sewer lines | 7 Pit privy | 12 Fertilizer storage | |
| 3 Watertight sewer lines | 8 Sewage lagoon | 13 Insecticide storage | |
| 4 Lateral lines | 9 Feedyard | 14 Abandoned water well | |
| 5 Cess Pool | 10 Livestock pens | 15 Oil well / Gas well | |

Direction from well? NORTH

How many feet? APPROX. 1300

FROM	TO	PLUGGING MATERIALS
125	3	BENTONITE HOLEPLUG
3	0	TOPSOIL

CONTRACTOR'S OR LANDOWNER'S CERTIFICATION: This water well was plugged under my jurisdiction and was completed on (mo/day/year) 11 / 22 / 00 and this record is true to the best of my knowledge and belief. Kansas Water Well Contractor's License No. N/A under the business name of EQUUS BEDS GMD2 by (signature) *[Signature]*

INSTRUCTIONS: Use typewriter or ball point pen. Please press firmly and print clearly. Please fill in blanks, and underline or circle the correct answers. Send top three copies to Kansas Department of Health and Environment, Bureau of Water, Topeka, Kansas 66620-0001. Telephone: 913/296-3565. Send one to Water Well Owner and retain one for your records.