64 5724 WATER WELL RECORD Form WWC-5 KSA 82a-1212 ID No. IW-1C

1 LOCATION OF WATER WELL:

County:	Fraction	Section Number	Township Number	Range Number
Harvey	NW 1/4 NW 1/4 NW 1/4	10	T 23 S	R 3 E (W)

Distance and direction from nearest town or city street address of well if located within city?
Approximately 3 miles north and 1 mile east of Burrton

2 WATER WELL OWNER: City of Wichita
RR#, St. Address, Box # : 455 N. Main
City, State, ZIP Code : Wichita, KS 67202

Board of Agriculture, Division of Water Resources
Application Number:

3 LOCATE WELL'S LOCATION WITH AN "X" IN SECTION BOX:

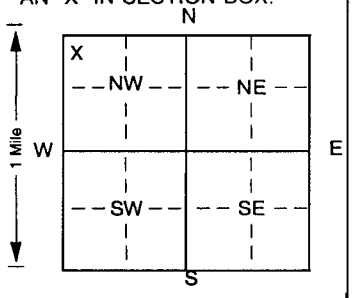

4 DEPTH OF COMPLETED WELL 104 ft. ELEVATION: unknown

Depth(s) Groundwater Encountered 1 _____ ft. 2 _____ ft. 3 _____ ft.

WELL'S STATIC WATER LEVEL not checked ft. below land surface measured on mo/day/yr _____

Pump test data: Well water was not checked ft. after _____ hours pumping _____ gpm

Est. Yield unknown gpm: Well water was _____ ft. after _____ hours pumping _____ gpm

Bore Hole Diameter 6 in. to 105 ft., and _____ in. to _____ ft.

WELL WATER TO BE USED AS: 1 Domestic 2 Irrigation 3 Feedlot 4 Industrial 5 Public water supply 6 Oil field water supply 7 Domestic (lawn & garden) 8 Air conditioning 9 Dewatering 10 Monitoring well 11 Injection well 12 Other (specify below) Index Well

Was a chemical/bacteriological sample submitted to Department? Yes _____ No ✓ If yes, mo/day/yrs sample was submitted _____ Water Well Disinfected? Yes _____ No ✓

5 TYPE OF BLANK CASING USED: 1 Steel (2) PVC 3 RMP (SR) 4 ABS 5 Wrought iron 6 Asbestos-Cement 7 Fiberglass 8 Concrete tile 9 Other (specify below)

CASING JOINTS: Glued ✓ Clamped _____ Welded _____ Threaded _____

Blank casing diameter 2 in. to 82 ft., Dia _____ in. to _____ ft., Dia _____ in. to _____ ft

Casing height above land surface 24 in., weight .96 lbs./ft. Wall thickness or gauge No .218

TYPE OF SCREEN OR PERFORATION MATERIAL: 1 Steel 2 Brass 3 Stainless steel 4 Galvanized steel 5 Fiberglass 6 Concrete tile (7) PVC 8 RMP (SR) 9 ABS 10 Asbestos-cement 11 Other (specify) _____ 12 None used (open hole)

SCREEN OR PERFORATION OPENINGS ARE: 1 Continuous slot 2 Louvered shutter (3) Mill slot 4 Key punched 5 Gauzed wrapped 6 Wire wrapped 7 Torch cut 8 Saw cut 9 Drilled holes 10 Other (specify) _____ 11 None (open hole)

SCREEN-PERFORATED INTERVALS: From 82 ft. to 102 ft., From _____ ft. to _____ ft.
From _____ ft. to _____ ft., From _____ ft. to _____ ft.

GRAVEL PACK INTERVALS: From 76 ft. to 104 ft., From _____ ft. to _____ ft.
From _____ ft. to _____ ft., From _____ ft. to _____ ft.

6 GROUT MATERIAL: (1) Neat cement 2 Cement grout 3 Bentonite 4 Other Bentonite Holeplug

Grout Intervals: From 0 ft. to 73 ft., From _____ ft. to _____ ft., From 73 ft. to 76 ft.

What is the nearest source of possible contamination:
1 Septic tank 2 Sewer lines 3 Watertight sewer lines 4 Lateral lines 5 Cess pool 6 Seepage pit 7 Pit privy 8 Sewage lagoon 9 Feedyard 10 Livestock pens 11 Fuel storage 12 Fertilizer storage 13 Insecticide storage 14 Abandoned water well 15 Oil well/Gas well 16 Other (specify below) None known

Direction from well? How many feet?

FROM	TO	LITHOLOGIC LOG	FROM	TO	PLUGGING INTERVALS
0	2	Topsoil			
2	13	Clay, tan and white, sandy			
13	45	Sand, fine, very fine			
45	56	Clay, brown, sandy, soft			
56	72	Clay, white, hard			
72	82	Clay, brown, sandy, hard			
82	103	Sand and gravel, medium, fine, very fine			
103	105	Shale, green, hard			

7 CONTRACTOR'S OR LANDOWNER'S CERTIFICATION: This water well was (1) constructed, (2) reconstructed, or (3) plugged under my jurisdiction and was completed on (mo/day/year) 6-21-01 and this record is true to the best of my knowledge and belief. Kansas Water Well Contractor's License No 185 This Water Well Record was completed on (mo/day/yr) 6-26-01 under the business name of Clarke Well & Equipment, Inc. by (signature) [signature]

INSTRUCTIONS: Use typewriter or ball point pen. *PLEASE PRESS FIRMLY* and *PRINT* clearly. Please fill in blanks, underline or circle the correct answers. Send top three copies to Kansas Department of Health and Environment, Bureau of Water, Topeka, Kansas 66620-0001. Telephone 785-296-5524. Send one to WATER WELL OWNER and retain one for your records. Fee of $5.00 for each constructed well.