

WATER WELL RECORD		Form WW-5		RSA 62a-1212 ID NO.	
1 LOCATION OF WATER WELL:		Fraction		Section Number	
County: <i>Harvey</i>		<i>SE 1/4 SW 1/4 SW 1/4</i>		<i>27</i>	
				Township Number	
				T <i>23</i> S	
				Range Number	
				R <i>3</i> E <i>W</i>	


Distance and direction from nearest town or city street address of well if located within city?

2 S, 1 1/4 E of Burton

2) WATER WELL OWNER : Melinda Miller
RR#, St. Address, Box # : Box 188, Rt 3
City, State, ZIP Code : Burrton, KS 67020

Board of Agriculture, Division of Water Resources
Application Number:

3 LOCATE WELL'S LOCATION WITH 4 DEPTH OF COMPLETED WELL. 43 ft. ELEVATION:

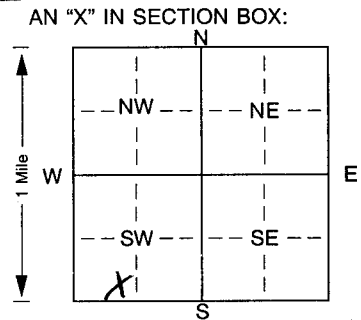

Depth(s) Groundwater Encountered 1. ft. 2. ft. 3. ft.
WELL'S STATIC WATER LEVEL . . . 1.9 . . . ft. below land surface measured on mo/day/yr . . . 7-8-01 . . .
Pump test data: Well water was . . . 22 . . . ft. after . . . 14 . . . hours pumping . . . 25 . . . gpm
Est. Yield gpm: Well water was ft. after hours pumping gpm
Bore Hole Diameter . . . 8 . . . in. to . . . 43 . . . ft., and in. to ft.
WELL WATER TO BE USED AS: 5 Public water supply 8 Air conditioning 11 Injection well
1 Domestic 3 Feedlot 6 Oil field water supply 9 Dewatering 12 Other (Specify below)
2 Irrigation 4 Industrial 7 Domestic (lawn & garden) 10 Monitoring well

Was a chemical/bacteriological sample submitted to Department? Yes. No. X . . . ; If yes, mo/day/yr sample was submitted
Water Well Disinfected? Yes X No

5 TYPE OF BLANK CASING USED:		5 Wrought iron	8 Concrete tile	CASING JOINTS: Glued. <input checked="" type="checkbox"/> Clamped.
1 Steel	3 RMP (SR)	6 Asbestos-Cement	9 Other (specify below)	Welded
2 PVC	4 ABS	7 Fiberglass		Threaded.

Blank casing diameter . . . 5 . . . in. to . . . 33 . . . ft., Dia . . . in. to . . . ft., Dia . . . in. to . . . ft.
Casing height above land surface. . . 12 . . . in., weight . . . 2.29 . . . lbs./ft. Wall thickness or gauge No. 160

TYPE OF SCREEN OR PERFORATION MATERIAL:			7 PVC	10 Asbestos-cement
1 Steel	3 Stainless steel	5 Fiberglass	8 RMP (SR)	11 Other (specify)
2 Brass	4 Galvanized steel	6 Concrete tile	9 ABS	12 None used (open hole)

SCREEN OR PERFORATION OPENINGS ARE:

1 Continuous slot	3 Mill slot	5 Gauzed wrapped	8 Saw cut	11 None (open hole)
2 Louvered shutter	4 Key punched	6 Wire wrapped	9 Drilled holes	
		7 Torch cut	10 Other (specify)	ft.

SCREEN-PERFORATED INTERVALS:	From. 33	ft. to 43	ft.	From	ft. to	ft.
	From.	ft. to	ft.	From	ft. to	ft.
GRAVEL PACK INTERVALS:	From. 23	ft. to 43	ft.	From	ft. to	ft.
	From.	ft. to	ft.	From	ft. to	ft.

6 GROUT MATERIAL: 1 Neat cement 2 Cement grout 3 Bentonite 4 Other
Grout Intervals: From 3 ft. to 23 ft. From ft. to ft. From ft. to ft.

What is the nearest source of possible contamination:

① Septic tank	4 Lateral lines	7 Pit privy	10 Livestock pens	14 Abandoned water well
2 Sewer lines	5 Cess pool	8 Sewage lagoon	11 Fuel storage	15 Oil well/Gas well
3 Watertight sewer lines	6 Seepage pit	9 Feedyard	12 Fertilizer storage	16 Other (specify below)
			13 Insecticide storage

Direction from well? S

How many feet? 120

[illegible]

7 CONTRACTOR'S OR LANDOWNER'S CERTIFICATION: This water well was (1) constructed, (2) reconstructed, or (3) plugged under my jurisdiction and was completed on (mo/day/year) 7-4-01 and this record is true to the best of my knowledge and belief. Kansas Water Well Contractor's Licence No. 447 This Water Well Record was completed on (mo/day/yr) 7-18-01 under the business name of Miller Drilling by (signature) [Signature]