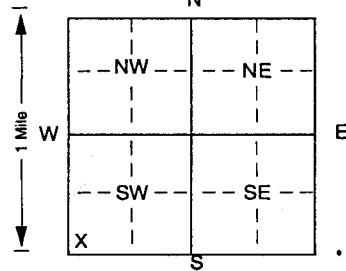


1 LOCATION OF WATER WELL:		Fraction	Section Number	Township Number	Range Number
County: Harvey		SW 1/4 SW 1/4 SW 1/4	12	T 23 S	R 3 E (W)

Distance and direction from nearest town or city street address of well if located within city?

Approximately 3 1/2 miles east and 2 miles north of Burrton

2 WATER WELL OWNER: City of Wichita		Board of Agriculture, Division of Water Resources
RR#, St. Address, Box # : 455 N. Main		Application Number:
City, State, ZIP Code : Wichita, KS 67202		

3 LOCATE WELL'S LOCATION WITH AN "X" IN SECTION BOX:		4 DEPTH OF COMPLETED WELL 126 ft. ELEVATION: unknown	
		Depth(s) Groundwater Encountered 1 ft. 2 ft. 3 ft.	
		WELL'S STATIC WATER LEVEL not checked ft. below land surface measured on mo/day/yr	
		Pump test data: Well water was not checked ft. after hours pumping gpm	
		Est. Yield unknown gpm: Well water was ft. after hours pumping gpm	
		Bore Hole Diameter 6 in. to 140 ft., and in. to ft.	
WELL WATER TO BE USED AS:		5 Public water supply 8 Air conditioning 11 Injection well	
1 Domestic 3 Feedlot 6 Oil field water supply 9 Dewatering 12 Other (specify below)			
2 Irrigation 4 Industrial 7 Domestic (lawn & garden) 10 Monitoring well			
Was a chemical/bacteriological sample submitted to Department? Yes No		If yes, mo/day/yr sample was submitted	
Water Well Disinfected? Yes No			

5 TYPE OF BLANK CASING USED:		5 Wrought iron 8 Concrete tile		CASING JOINTS: Glued Clamped	
1 Steel 3 RMP (SR)		6 Asbestos-Cement 9 Other (specify below)		Welded	
2 PVC 4 ABS		7 Fiberglass		Threaded	
Blank casing diameter 2 in. to 84 ft., Dia		in. to ft., Dia		in. to ft.	
Casing height above land surface 24 in., weight .70		lbs./ft. Wall thickness or gauge No .154			
TYPE OF SCREEN OR PERFORATION MATERIAL:		7 PVC 10 Asbestos-cement			
1 Steel 3 Stainless steel 5 Fiberglass 8 RMP (SR)		11 Other (specify)			
2 Brass 4 Galvanized steel 6 Concrete tile 9 ABS		12 None used (open hole)			
SCREEN OR PERFORATION OPENINGS ARE:		5 Gauzed wrapped 8 Saw cut 11 None (open hole)			
1 Continuous slot 3 Mill slot 6 Wire wrapped 9 Drilled holes		10 Other (specify)		ft.	
2 Louvered shutter 4 Key punched 7 Torch cut				ft.	
SCREEN-PERFORATED INTERVALS: From 84 ft. to 124 ft., From		ft. to ft.		ft.	
GRAVEL PACK INTERVALS: From 55 ft. to 140 ft., From		ft. to ft.		ft.	
From		ft. to ft.		ft.	

6 GROUT MATERIAL: 1 Neat cement 2 Cement grout 3 Bentonite 4 Other Bentonite Holeplug	
Grout Intervals: From ft. to ft., From ft. to ft., From 0 ft. to 55 ft.	
What is the nearest source of possible contamination:	
1 Septic tank 4 Lateral lines 7 Pit privy 10 Livestock pens 14 Abandoned water well	
2 Sewer lines 5 Cess pool 8 Sewage lagoon 11 Fuel storage 15 Oil well/Gas well	
3 Watertight sewer lines 6 Seepage pit 9 Feedyard 12 Fertilizer storage 16 Other (specify below)	
13 Insecticide storage None known	
Direction from well? How many feet?	

FROM	TO	LITHOLOGIC LOG	FROM	TO	PLUGGING INTERVALS
0	3	Topsoil	103	109	Clay, green, hard
3	13	Clay, brown, sandy, soft	109	124	Sand, coarse to very fine with gravel, fine
13	17	Clay, reddish brown, sandy, soft	124	129	Clay, dark gray
17	27	Sand, coarse to very fine, loose	129	140	Shale, black, hard
27	58	Clay, tan, hard			
58	62	Sand, coarse to very fine, loose			
62	64	Clay, green, hard			
64	76	Sand, coarse to very fine, loose, clean			
76	77	Clay, green, hard			
77	82	Sand, coarse to very fine with gravel, fine, loose, clean			
82	91	Clay, green, hard, sand streak at 89'			
91	103	Sand, coarse to very fine with gravel, fine, loose, clean			

7 CONTRACTOR'S OR LANDOWNER'S CERTIFICATION: This water well was (1) constructed, (2) reconstructed, or (3) plugged under my jurisdiction and was completed on (mo/day/year) 12-19-02 and this record is true to the best of my knowledge and belief. Kansas Water Well Contractor's License No 185 This Water Well Record was completed on (mo/day/yr) 12-31-02 under the business name of Clarke Well & Equipment, Inc. by (signature)	
--	--