

1	LOCATION OF WATER WELL:	Fraction	Form WWC-5	Section Number	Township Number	Range Number
County:	Harvey	NE 1/4 NW 1/4 SE 1/4		13	T 23 S	R 3 E/W

Distance and direction from nearest town or city street address of well if located within city?

From Burton. 4 East, 1 1/2 North of Burrton, Ks.

2 WATER WELL OWNER:

RR#, St. Address, Box # :

City, State, ZIP Code :

Larry Flickinger
431 North River Park Road
Burrton, Kansas 67020

Board of Agriculture, Division of Water Resources

Application Number:


3 LOCATE WELL'S LOCATION WITH

4 DEPTH OF COMPLETED WELL

1.68

ft. ELEVATION:

AN "X" IN SECTION BOX:

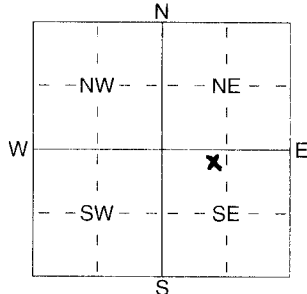

Depth(s) Groundwater Encountered

1

ft. 2

ft. 3

WELL'S STATIC WATER LEVEL

54

ft. below land surface measured on mo/day/yr.

02/20/03

Pump test data: Well water was

Est. Yield

WELL WATER TO BE USED AS:

1 Domestic

3 Feedlot

6 Oil field water supply

8 Air conditioning

11 Injection well

2 Irrigation

4 Industrial

7 Domestic (lawn & garden)

10 Monitoring well

12 Other (Specify below)

Was a chemical/bacteriological sample submitted to Department? Yes No X; If yes, mo/day/yr sample was submitted Water Well Disinfected? Yes X No

5 TYPE OF BLANK CASING USED:

5 Wrought iron

8 Concrete tile

CASING JOINTS: Glued Clamped

1 Steel

3 RMP (SR)

6 Asbestos-Cement

9 Other (specify below)

Welded

2 PVC

4 ABS

7 Fiberglass

Threaded

Blank casing diameter

16

in. to 128

ft., Dia

in. to

ft., Dia

in. to

Casing height above land surface

12

in., weight

SCH 40

lbs./ft. Wall thickness or guage No.

500

TYPE OF SCREEN OR PERFORATION MATERIAL:

1 Steel

3 Stainless Steel

5 Fiberglass

7 PVC

10 Asbestos-Cement

2 Brass

4 Galvanized Steel

6 Concrete tile

8 RMP (SR)

11 Other (Specify)

12 None used (open hole)

SCREEN OR PERFORATION OPENINGS ARE:

1 Continuous slot

3 Mill slot

5 Gauzed wrapped

8 Saw cut

11 None (open hole)

2 Louvered shutter

4 Key punched

6 Wire wrapped

9 Drilled holes

7 Torch cut

10 Other (specify)

SCREEN-PERFORATED INTERVALS: From

128

ft. to

168

ft., From

From

GRAVEL PACK INTERVALS: From

168

ft. to

20

ft., From

From

6 GROUT MATERIAL:

1 Neat cement

2 Cement grout

3 Bentonite

4 Other Hole Plug

Grout intervals: From

20

ft. to

0

ft., From

ft. to

ft., From

ft. to

ft., From

ft. to

What is the nearest source of possible contamination:

1 Septic tank

4 Lateral lines

7 Pit privy

10 Livestock pens

14 Abandoned water well

2 Sewer lines

5 Cess pool

8 Sewage lagoon

11 Fuel storage

15 Oil well/Gas well

3 Watertight sewer lines

6 Seepage pit

9 Feedyard

12 Fertilizer storage

16 Other (specify below)

13 Insecticide storage

NONE

Direction from well?

How many feet?

FROM	TO	LITHOLOGIC LOG	FROM	TO	PLUGGING INTERVALS
0	3	Siltier Top Soil			
3	7	Light Brown Clay			
7	12	tan Clay & Fine Sand			
12	16	Fine Sand & tan Clay mix			
16	27	Fine Sand			
27	53	tan Clay			
53	75	Fine Sand w/ Pieces of Clay			
75	82	Small to Medium Sand w/ Pieces of Clay			
82	87	Fine to Small Sand w/ Pieces of Clay			
87	95	Fine Sand			
95	105	Fine Sand w/ Light Grey Clay & little pieces of Caliche			
105	125	tan Clay			
125	168	Fine to Small Sand w/ pieces of Clay			

7 CONTRACTOR'S OR LANDOWNER'S CERTIFICATION: This water well was (1) constructed, (2) reconstructed, or (3) plugged under my jurisdiction and was

completed on (mo/day/year)

02/20/03

Water Well Contractor's Licence No

134

under the business name of

Rasneranty Bemis Est.

This Water Well Record was completed on (mo/day/yr)

02/25/03

by (signature)

Dwain Dodson