

1 LOCATION OF WATER WELL: County: <u>Harvey</u>	Fraction $\frac{1}{4}$ <u>N</u> $\frac{1}{4}$ <u>E</u>	Section Number <u>28</u>	Township Number T <u>23</u> S	Range Number R <u>3</u> E <u>(W)</u>
---	--	--------------------------	-------------------------------	--------------------------------------

Distance and direction from nearest town or city street address of well if located within city?


From Burton, KS: $\frac{3}{4}$ mile South and $\frac{3}{4}$ mile East2 WATER WELL OWNER: June EdlundRR#, St. Address, Box # : 3707 Asberry Dr Apt. 102City, State, ZIP Code : Hutchinson, KS 67501

Board of Agriculture, Division of Water Resources

Application Number: 45,047

3 LOCATE WELL'S LOCATION WITH 4 DEPTH OF COMPLETED WELL ft. ELEVATION:

AN "X" IN SECTION BOX:

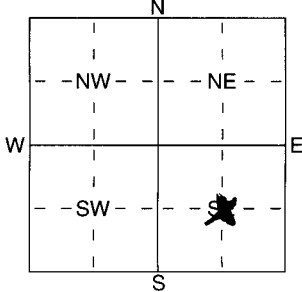

Depth(s) Groundwater Encountered ft. 1 ft. 2 ft. 3 ft.

WELL'S STATIC WATER LEVEL 15 ft. below land surface measured on mo/day/yr 12-21-04

Pump test data: Well water was ft. after hours pumping gpm

Est. Yield 700 gpm: Well water was ft. after hours pumping gpm

WELL WATER TO BE USED AS: 5 Public water supply 8 Air conditioning 11 Injection well

1 Domestic 3 Feedlot 6 Oil field water supply 9 Dewatering 12 Other (Specify below)

2 Irrigation 4 Industrial 7 Domestic (lawn & garden) 10 Monitoring well

Was a chemical/bacteriological sample submitted to Department? Yes No X; If yes, mo/day/yr sample was submitted Water Well Disinfected? Yes X No5 TYPE OF BLANK CASING USED: 5 Wrought iron 8 Concrete tile CASING JOINTS: Glued X Clamped

1 Steel 3 RMP (SR) 6 Asbestos-Cement 9 Other (specify below) Welded

2 PVC 4 ABS 7 Fiberglass Threaded

Blank casing diameter 16 in. to 25 ft., Dia in. to ft., Dia in. to ft.Casing height above land surface 12 in., weight 16 lbs./ft. Wall thickness or gauge No. 1/2"

TYPE OF SCREEN OR PERFORATION MATERIAL:

1 Steel 3 Stainless Steel 5 Fiberglass 8 RMP (SR) 10 Asbestos-Cement

2 Brass 4 Galvanized Steel 6 Concrete tile 9 ABS 11 Other (Specify)

SCREEN OR PERFORATION OPENINGS ARE: 5 Guazed wrapped 8 Saw cut 11 None (open hole)

1 Continuous slot 3 Mill slot 6 Wire wrapped 9 Drilled holes

2 Louvered shutter 4 Key punched 7 Torch cut 10 Other (specify) ft.

SCREEN-PERFORATED INTERVALS: From 25 ft. to 45 ft., From ft. to ft.

From ft. to ft., From ft. to ft.

GRAVEL PACK INTERVALS: From 20 ft. to 45 ft., From ft. to ft.

From ft. to ft., From ft. to ft.

6 GROUT MATERIAL: 1 Neat cement 3 Cement grout 3 Bentonite 4 Other

Grout Intervals: From 3 ft. to 20 ft., From ft. to ft., From ft. to ft.

What is the nearest source of possible contamination:

1 Septic tank 4 Lateral lines 7 Pit privy 10 Livestock pens 14 Abandoned water well

2 Sewer lines 5 Cess pool 8 Sewage lagoon 11 Fuel storage 15 Oil well/Gas well

3 Watertight sewer lines 6 Seepage pit 9 Feedyard 12 Fertilizer storage 16 Other (specify below)

Direction from well?

How many feet? None

FROM TO LITHOLOGIC LOG FROM TO PLUGGING INTERVALS

0 3 Topsoil

3 6 Clay

6 20 Fine Sand

20 45 Small Gravel

45 Tan Clay

7 CONTRACTOR'S OR LANDOWNER'S CERTIFICATION: This water well was (1) constructed, (2) reconstructed, or (3) plugged under my jurisdiction and was completed on (mo/day/year) 12-21-04 and this record is true to the best of my knowledge and belief. KansasWater Well Contractor's Licence No 238 This Water Well Record was completed on (mo/day/yr) 12-23-04under the business name of Weninger Irrigation by (signature) Gusta Weninger