WATER WELL RECORD Form WWC-5 KSA 82a-1212 ID No. 00157142

1 LOCATION OF WATER WELL:	Fraction	Section Number	Township Number	Range Number
County: Harvey	NW ¼ NW ¼ NE ¼	29	T 23 S	R 3 E (W)

Distance and direction from nearest town or city street address of well if located within city?
Hensley Oil, 203 W. Dean, Burrton, Ks

2 WATER WELL OWNER: Phil Hoskinson
RR#, St. Address, Box # : Box 138
City, State, ZIP Code : Burton, Ks 67020

Board of Agriculture, Division of Water Resources
Application Number: AS-11

3 LOCATE WELL'S LOCATON WITH AN "X" IN SECTION BOX:

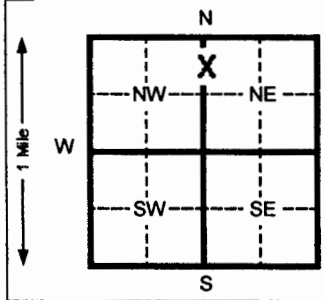

4 DEPTH OF COMPLETED WELL 32 ft. ELEVATION: 1450.55
Depth(s) Groundwater Encountered 1 ____ ft. 2 ____ ft. 3 ____ ft.
WELL'S STATIC WATER LEVEL NA ft. below land surface measured on mo/day/yr ____
Pump test data: Well water was ____ ft. after ____ hours pumping ____ gpm
Est. Yield ____ gpm: Well water was ____ ft. after ____ hours pumping ____ gpm
Bore Hole Diameter 8 in. to 32 ft. and ____ in. to ____ ft.
WELL WATER TO BE USED AS: 5 Public water supply 8 Air conditioning 11 Injection well
1 Domestic 3 Feed lot 6 Oil field water supply 9 Dewatering 12 Other (Specify below)
2 Irrigation 4 Industrial 7 Lawn and garden (domestic) (10) Monitoring well
Was a chemical/bacteriological sample submitted to Department? Yes ____ No X If yes, mo/day/yr sample was submitted
Water Well Disinfected? Yes ____ No X

5 TYPE OF BLANK CASING USED: 5 Wrought Iron 8 Concrete tile CASING JOINTS: Glued ____ Clamped ____
1 Steel 3 RMP (SR) 6 Asbestos-Cement 9 Other (specify below) Welded ____
(2) PVC 4 ABS 7 Fiberglass Threaded X
Blank casing diameter 2 in. to 30 ft., Dia ____ in. to ____ ft., Dia ____ in. to ____ ft.
Casing height above land surface 0 in., weight .716 lbs./ft. Wall thickness or gauge No. .154
TYPE OF SCREEN OR PERFORATION MATERIAL: (7) PVC 10 Asbestos-cement
1 Steel 3 Stainless steel 5 Fiberglass 8 RMP (SR) 11 Other (specify) ____
2 Brass 4 Galvanized steel 6 Concrete tile 9 ABS 12 None used (open hole)
SCREEN OR PERFORATION OPENINGS ARE: 5 Gauzed wrapped (8) Saw cut 11 None (open hole)
1 Continuous slot 3 Mill slot 6 Wire wrapped 9 Drilled holes
2 Louvered shutter 4 Key punched 7 Torch cut 10 Other (specify) ____
SCREEN-PERFORATED INTERVALS: From 30 ft. to 32 ft. From ____ ft. to ____ ft.
From ____ ft. to ____ ft. From ____ ft. to ____ ft.
GRAVEL PACK INTERVALS: From 28 ft. to 32 ft. From ____ ft. to ____ ft.
From ____ ft. to ____ ft. From ____ ft. to ____ ft.

6 GROUT MATERIAL: 1 Neat cement 2 Cement grout 3 Bentonite 4 Other ____
Grout Intervals From 2 ft. to 28 ft. From ____ ft. to ____ ft. From ____ ft. to ____ ft.
What is the nearest source of possible contamination: 10 Livestock pens 14 Abandoned water well
1 Septic tank 4 Lateral lines 7 Pit privy 11 Fuel storage 15 Oil well/ Gas well
2 Sewer lines 5 Cess pool 8 Sewage lagoon 12 Fertilizer storage (16) Other (specify below)
3 Watertight sewer lines 6 Seepage pit 9 Feedyard 13 Insecticide storage Contaminated site
Direction from well? How many feet?

FROM	TO	CODE	LITHOLOGIC LOG	FROM	TO	PLUGGING INTERVALS
0	.5		Cement			
.5	4		Dense sandy clay			
4	9		Clayey silt tso silty clay			
9	32		Loose sand & gravel			

7 CONTRACTOR'S OR LANDOWNER'S CERTIFICATION: This water well was (1) constructed, (2) reconstructed, or (3) plugged under my jurisdiction and was completed on (mo/day/yr) 12-16-04 and this record is true to the best of my knowledge and belief. Kansas Water Well Contractor's License No. 554 This Water Well Record was completed on (mo/day/yr) 4-01-04
under the business name of Woofter Pump & Well Inc. by (signature) Jay C Woofter

INSTRUCTIONS:. Please fill in blanks and circle the correct answers. Send three copies to Kansas Department of Health and Environment, Bureau of Water, 1900 S W Jackson St., Ste. 420, Topeka, Kansas 66612-1367. Telephone: 913-296-5545. Send one to WATER WELL OWNER and retain one for your records.

OFFICE USE ONLY
T
R
SEC

Form provided by Forms-On-A-Disk, Inc. · Dallas, Texas · (214) 340-9429