

LOCATION OF WATER WELL: HARVEY	Fraction NW 1/4 NW 1/4 NW 1/4	Section Number 36	Township Number 23 SOUTH	Range Number 03 WEST
-----------------------------------	----------------------------------	----------------------	-----------------------------	-------------------------

Distance and direction from nearest town or city street address of well if located within city?
APPROX. 50 FT. SOUTH AND 30 FT. EAST OF THE INTERSECTION OF SW 24TH ST. AND SOUTH WILLOW LAKE RD., HALSTEAD, KS

WATER WELL OWNER: EQUUS BEDS GMD2

RR#, St. Address, Box #: 313 SPRUCE STREET
City, State, ZIP Code: HALSTEAD KS 67056-1925

Board of Agriculture, Division of Water Resources
Application Number: NA

MARK WELL'S LOCATION WITH AN "X" IN SECTION BOX

N	
X - EB20A	
S	

DEPTH OF WELL 53 ft.

WELL'S STATIC WATER LEVEL 30.11 ft.

WELL WAS USED AS:

1 Domestic	5 Public Water Supply	9 Dewatering
2 Irrigation	6 Oil Field Water Supply	10 Monitoring Well EB20A
3 Feedlot	7 Lawn and Garden Only	11 Injection Well
4 Industrial	8 Air Conditioning	12 Other

Was a chemical/bacteriological sample submitted to Department? Yes ☐ No ☒

If yes, mo/day/yr sample was submitted : / /

WaterWell Disinfected: Yes ☒ No ☐

TYPE OF BLANK CASING USED:

1 Steel	3 RMP (SR)	5 Wrought	7 Fiberglass	9 Other ____
2 PVC	4 ABS	6 Asbestos-Cement	8 Concrete Tile	

Blank casing diameter 1.25 in. Was casing pulled? Yes ☐ No ☒ if yes, how much 0.0 ft bls

Casing height ~~above or~~ below land surface 6.0 feet.

GROUT PLUG MATERIAL: 1 Neat cement 2 Cement grout **3 Bentonite** 4 Other

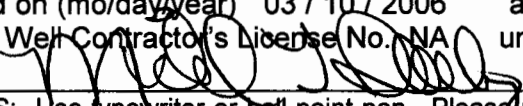
Grout Plug Intervals: From 53 ft. to 6 ft.

What is the nearest source of possible contamination:

1 Septic tank	6 Seepage pit	11 Fuel Storage	16 Other
2 Sewer lines	7 Pit privy	12 Fertilizer storage	
3 Watertight sewer lines	8 Sewage lagoon	13 Insecticide storage	
4 Lateral lines	9 Feedyard	14 Abandoned water well	
5 Cess Pool	10 Livestock pens	15 Oil well / Gas well	

Direction from well? east How many feet? 800

FROM	TO	PLUGGING MATERIALS
53	6	Bentonite, HolePlug
6	0	Topsoil

CONTRACTOR'S OR LANDOWNER'S CERTIFICATION: This water well was plugged under my jurisdiction and was completed on (mo/day/year) 03 / 10 / 2006 and this record is true to the best of my knowledge and belief. Kansas Water Well Contractor's License No. NA under the business name of Equus Beds GMD2 by (signature) 

INSTRUCTIONS: Use typewriter or ball point pen. Please press firmly and print clearly. Please fill in blanks, and underline or circle the correct answers. Send top three copies to Kansas Department of Health and Environment, Bureau of Water, Topeka, Kansas 66620-0001. Telephone: 913/296-3565. Send one to Water Well Owner and retain one for your records.