WATER WELL PLUGGING RECORD Form WWC-5P KSA 82a-1212

LOCATION OF WATER WELL: HARVEY	Fraction: NW ¼ NW ½ NW ¼	Section Number: 10	Township Number: 23 SOUTH	Range Number: 03 WEST

Distance and direction from nearest town or city street address of well if located within city?
APPROXIMATELY 1 MILE EAST AND 3 MILES NORTH OF BURRTON, KS

WATER WELL OWNER:
RR#, St. Address, Box #: EQUUS BEDS GROUNDWATER MANAGEMENT DISTRICT NO. 2 313 SPRUCE STREET
City, State, ZIP Code: HALSTEAD, KS 67056

Board of Agriculture, Division of Water Resources
Application Number:

MARK WELL'S LOCATION WITH AN "X" IN SECTION BOX

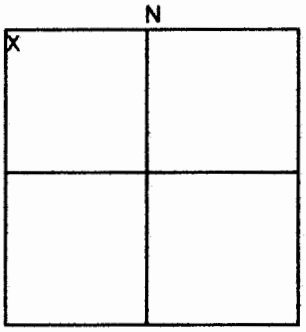

DEPTH OF WELL 103 ft.

WELL'S STATIC WATER LEVEL 57.95 ft.

WELL WAS USED AS:

1 Domestic 2 Irrigation 3 Feedlot 4 Industrial 5 Public Water Supply 6 Oil Field Water Supply 7 Lawn and Garden Only 8 Air Conditioning 9 Dewatering **10 Monitoring Well – EB22B** 11 Injection Well 12 Other

Was a chemical/bacteriological sample submitted to Department? Yes ☐ No ☒
If yes, mo/day/yr sample was submitted : / /

WaterWell Disinfected: Yes ☒ No ☐

TYPE OF BLANK CASING USED:

1 Steel **2 PVC** 3 RMP (SR) 4 ABS 5 Wrought 6 Asbestos-Cement 7 Fiberglass 8 Concrete Tile 9 Other

Blank casing diameter 2.0 in. Was casing pulled? Yes ☐ No ☒ if yes, how much 0.0 ft bls
Casing height ~~above or~~ below land surface 3 feet.

GROUT PLUG MATERIAL: 1 Neat cement 2 Cement grout **3 Bentonite** 4 Other

Grout Plug Intervals: From 103 ft. to 3 ft.

What is the nearest source of possible contamination:

1 Septic tank 2 Sewer lines 3 Watertight sewer lines 4 Lateral lines 5 Cess Pool 6 Seepage pit 7 Pit privy 8 Sewage lagoon 9 Feedyard 10 Livestock pens 11 Fuel Storage 12 Fertilizer storage 13 Insecticide storage 14 Abandoned water well 15 Oil well / Gas well **16 Other – grazing livestock**

Direction from well? West How many feet? approximately 50 ft.

FROM	TO	PLUGGING MATERIALS
103	3	Bentonite, HolePlug
3	0	Topsoil

CONTRACTOR'S OR LANDOWNER'S CERTIFICATION: This water well was plugged under my jurisdiction and was completed on (mo/day/year) 11 / 30 / 2009 and this record is true to the best of my knowledge and belief. Kansas Water Well Contractor's License No. NA under the business name of Equus Beds GMD2 .

by (signature) Tim Boese, GMD2 12-22-09

INSTRUCTIONS: Use typewriter or ball point pen. Please press firmly and print clearly. Please fill in blanks, and underline or circle the correct answers. Send top three copies to Kansas Department of Health and Environment, Bureau of Water, Topeka, Kansas 66620-0001. Telephone: 913/296-3565. Send one to Watrer Well Owner and retain one for your records.