

**WATER WELL PLUGGING RECORD Form WWC-5P KSA 82a-1212 ID NO.**

32815

<b>1 LOCATION OF WATER WELL:</b> County: <u>Harvey</u>	Fraction $\frac{1}{4}$ $\frac{1}{4}$ NC $\frac{1}{4}$ NE $\frac{1}{4}$	Section Number <u>24</u>	Township Number T <u>23</u> S	Range Number <u>3</u> <input type="checkbox"/> E <input checked="" type="checkbox"/> W
---	---	-----------------------------	----------------------------------	---


Street/Rural Address of Well Location; if unknown, distance & direction from nearest town or intersection: If at owner's address, check here ☐ Approximately 3.75 miles east and 0.75 miles north of Burrton, KS

**Global Positioning Systems (GPS) information:**  
 Latitude: 38.03959 (in decimal degrees)  
 Longitude: -97.59625 (in decimal degrees)  
 Elevation:  
 Horizontal Datum: ☐ WGS84, ☐ NAD83, ☒ NAD27  
 Collection Method:

**2 WATER WELL OWNER:** Joseph H. Bergkamp  
 RR#, St. Address, Box #: 2004 S. Willow Lake Rd.  
 City, State ZIP Code: Halstead, KS 67056

☒ GPS unit (Make/Model: Garmin GPSmap 60CSx)  
☐ Digital Map/Photo, ☐ Topographic Map, ☐ Land Survey  
 Est. Accuracy: ☐ < 3 m, ☒ 3-5 m, ☐ 5-15 m, ☐ > 15 m

**3 MARK WELL'S LOCATION WITH AN "X" IN SECTION BOX:**

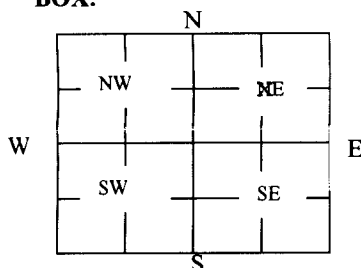

**4 DEPTH OF WELL** 230 **ft.**

WELL'S STATIC WATER LEVEL 25 ft

WELL WAS USED AS:

- |  |   |   |
|--|---|---|
| <input type="checkbox"/> Domestic              | <input type="checkbox"/> Public Water Supply      | <input type="checkbox"/> Dewatering     |
| <input checked="" type="checkbox"/> Irrigation | <input type="checkbox"/> Oil Field Water Supply   | <input type="checkbox"/> Monitoring     |
| <input type="checkbox"/> Feedlot               | <input type="checkbox"/> Domestic (Lawn & Garden) | <input type="checkbox"/> Injection Well |
| <input type="checkbox"/> Industrial            | <input type="checkbox"/> Air Conditioning         | <input type="checkbox"/> Other _____    |

Was a chemical/bacteriological sample submitted to Department? Yes ☐ No ☒

**5 TYPE OF BLANK CASING USED:**

- ☐ Steel ☐ RMP (SR) ☐ Wrought ☐ Fiberglass ☐ Other (Specify below)  
☐ PVC ☐ ABS ☒ Asbestos-Cement ☐ Concrete Tile

RECEIVED

MAR 16 2018

Blank casing diameter 16 in. Was casing pulled? Yes ☐ No ☒ If yes, how much \_\_\_\_\_ Equus \_\_\_\_\_  
 Casing height above or below land surface below 36 in.

**6 GROUT PLUG MATERIAL:** ☐ Neat cement ☒ Cement grout ☐ Bentonite ☐ Other \_\_\_\_\_

Grout Plug Intervals: From 25 ft. to 3 ft., From \_\_\_\_\_ ft. to \_\_\_\_\_ ft., From \_\_\_\_\_ ft. to \_\_\_\_\_ ft.

What is the nearest source of possible contamination:

- |   |   |  |  |
|---|---|--|--|
| <input type="checkbox"/> Septic tank            | <input type="checkbox"/> Seepage pit    | <input type="checkbox"/> Fuel storage                  | <input type="checkbox"/> Other (specify below) _____ |
| <input type="checkbox"/> Sewer lines            | <input type="checkbox"/> Pit privy      | <input checked="" type="checkbox"/> Fertilizer storage |  |
| <input type="checkbox"/> Watertight sewer lines | <input type="checkbox"/> Sewage lagoon  | <input type="checkbox"/> Insecticide storage           |  |
| <input type="checkbox"/> Lateral lines          | <input type="checkbox"/> Feedyard       | <input type="checkbox"/> Abandoned water well          |  |
| <input type="checkbox"/> Cess pool              | <input type="checkbox"/> Livestock pens | <input type="checkbox"/> Oil well/Gas well             |  |
- Direction from well? West  
 How many feet? approximately 27 ft.

FROM	TO	PLUGGING MATERIALS	FROM	TO	PLUGGING MATERIALS
230	213.7	Formation Sand (Casing Collapsed)			Well plugged witnessed by
213.7	25	Clean, Course Sand			D. Randolph, GMD2 staff, on 12/8/17.
25	3	Cement Grout			Well plugging completed on 3/1/18.
3	0	Topsoil			

**7 CONTRACTOR'S OR LANDOWNER'S CERTIFICATION:** This water well was plugged under my jurisdiction and was completed on (mo/day/year) 3/1/2018 and this record is true to the best of my knowledge and belief. Kansas Water Well Contractor's License No. \_\_\_\_\_. This Water Well Record was completed on (mo/day/year) 3/12/2018 under the business name of Joe Bergkamp by (signature) Joe Bergkamp

Send one white copy to Kansas Department of Health & Environment, Geology Section, 1000 SW Jackson Street, Ste. 420, Topeka, KS 66612-1367. Send one copy to WATER WELL OWNER and retain one for your records.  
 Visit us at <http://www.kdheks.gov/waterwell/index.html> Telephone 785-296-5524.

KSA82a-1212

Revised 1/20/2015