

**WATER WELL PLUGGING RECORD Form WWC-5P**

**KSA 82a-1212 ID NO.**

42968


<b>1 LOCATION OF WATER WELL:</b> County: Harvey	Fraction SE ¼ SW ¼ NE ¼ NE ¼	Section Number 27	Township Number 23 T S	Range Number 3 <input type="checkbox"/> E <input checked="" type="checkbox"/> W
--	---------------------------------	----------------------	---------------------------	--

Street/Rural Address of Well Location: if unknown, distance & direction from nearest town or intersection: If at owner's address, check here  From Burrton 1 3/4E SSR  
John C & Deloris I Trust c/o

**Global Positioning Systems (GPS) information:**  
Latitude: 38.02558 (in decimal degrees)  
Longitude: 097.63158 (in decimal degrees)  
Elevation: 1441  
Horizontal Datum:  WGS84,  NAD83,  NAD27  
Collection Method:

**2 WATER WELL OWNER:** Terry C. Gray  
RR#, St. Address, Box #: 3069 La Pietra Circle  
City, State ZIP Code: Honolulu, Hi 96815-4736

GPS unit (Make/Model: Garmin 62S)  
 Digital Map/Photo,  Topographic Map,  Land Survey  
Est. Accuracy:  < 3 m,  3-5 m,  5-15 m,  > 15 m

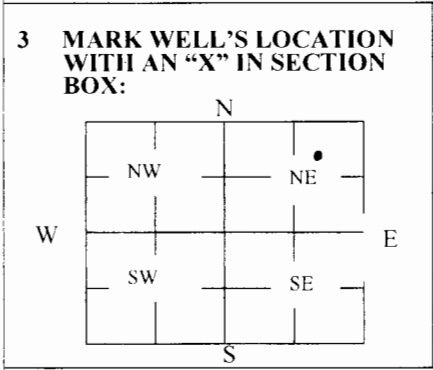

**4 DEPTH OF WELL** 124' 6" ft.  
WELL'S STATIC WATER LEVEL 22 ft  
WELL WAS USED AS:  
 Domestic  Public Water Supply  Dewatering  
 Irrigation  Oil Field Water Supply  Monitoring  
 Feedlot  Domestic (Lawn & Garden)  Injection Well  
 Industrial  Air Conditioning  Other \_\_\_\_\_  
Was a chemical/bacteriological sample submitted to Department? Yes  No

**5 TYPE OF BLANK CASING USED:**  
 Steel  RMP (SR)  Wrought  Fiberglass  Other (Specify below)  
 PVC  ABS  Asbestos-Cement  Concrete Tile  
Blank casing diameter 16 in. Was casing pulled? Yes  No  If yes, how much \_\_\_\_\_  
Casing height above or below land surface 60 in.

**6 GROUT PLUG MATERIAL:**  Neat cement  Cement grout  Bentonite  Other Dirt - Sand  
Grout Plug Intervals: From 0 ft. to 5 ft., From 5 ft. to 27 ft., From 27 ft. to 124' 6" ft.  
What is the nearest source of possible contamination:  
 Septic tank  Seepage pit  Fuel storage  Other (specify below) Irrigation well  
 Sewer lines  Pit privy  Fertilizer storage  
 Watertight sewer lines  Sewage lagoon  Insecticide storage  
 Lateral lines  Feedyard  Abandoned water well Direction from well? West  
 Cess pool  Livestock pens  Oil well/Gas well How many feet? 30

FROM	TO	PLUGGING MATERIALS	FROM	TO	PLUGGING MATERIALS
0	5	Dirt			
5	27	Bentonite			
27	124' 6"	Sand			

**7 CONTRACTOR'S OR LANDOWNER'S CERTIFICATION:** This water well was plugged under my jurisdiction and was completed on (mo/day/year) 1-29-2019 and this record is true to the best of my knowledge and belief. Kansas Water Well Contractor's License No. 134. This Water Well Record was completed on (mo/day/year) 1-31-2019 under the business name of Rosencrantz-Bemis Ent. by (signature) Jessica Dabson

Send one white copy to Kansas Department of Health & Environment, Geology Section, 1000 SW Jackson Street, Ste. 420, Topeka, KS 66612-1367. Send one copy to WATER WELL OWNER and retain one for your records.  
Visit us at <http://www.kdheks.gov/waterwell/index.html> Telephone 785-296-5524.