

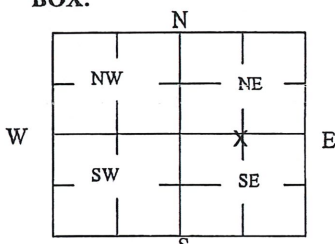
## WATER WELL PLUGGING RECORD Form WWC-5P

KSA 82a-1212

ID NO.

42232

1 LOCATION OF WATER WELL: County: Harvey	Fraction ¼ ¼ CN ¼ SE ¼	Section Number 26	Township Number T 23 S	Range Number 3 <input type="checkbox"/> E <input checked="" type="checkbox"/> W
Street/Rural Address of Well Location; if unknown, distance & direction from nearest town or intersection: If at owner's address, check here <input type="checkbox"/> Approximately 3 miles east and 0.5 miles south of Burton, KS		Global Positioning Systems (GPS) information: Latitude: 38.02134 (in decimal degrees) Longitude: -97.61492 (in decimal degrees) Elevation: Horizontal Datum: <input type="checkbox"/> WGS84, <input checked="" type="checkbox"/> NAD83, <input type="checkbox"/> NAD27 Collection Method: <input checked="" type="checkbox"/> GPS unit (Make/Model: Garmin GPSmap 60CSx) <input type="checkbox"/> Digital Map/Photo, <input type="checkbox"/> Topographic Map, <input type="checkbox"/> Land Survey Est. Accuracy: <input type="checkbox"/> < 3 m, <input checked="" type="checkbox"/> 3-5 m, <input type="checkbox"/> 5-15 m, <input type="checkbox"/> > 15 m		
2 WATER WELL OWNER: Gordon J. Bergkamp RR#, St. Address, Box #: 18826 W. 1st St. City, State ZIP Code: Burton, KS 67020				

3 MARK WELL'S LOCATION WITH AN "X" IN SECTION BOX: 	4 DEPTH OF WELL 87 ft. WELL'S STATIC WATER LEVEL 23 (3/6/23) ft WELL WAS USED AS: <input type="checkbox"/> Domestic <input type="checkbox"/> Public Water Supply <input type="checkbox"/> Dewatering <input checked="" type="checkbox"/> Irrigation <input type="checkbox"/> Oil Field Water Supply <input type="checkbox"/> Monitoring <input type="checkbox"/> Feedlot <input type="checkbox"/> Domestic (Lawn & Garden) <input type="checkbox"/> Injection Well <input type="checkbox"/> Industrial <input type="checkbox"/> Air Conditioning <input type="checkbox"/> Other Was a chemical/bacteriological sample submitted to Department? Yes <input type="checkbox"/> No <input type="checkbox"/>
---	--

5 TYPE OF BLANK CASING USED:

☐ Steel ☐ RMP (SR) ☐ Wrought ☐ Fiberglass ☐ Other (Specify below)  
☒ PVC ☐ ABS ☐ Asbestos-Cement ☐ Concrete Tile

Blank casing diameter 16 in. Was casing pulled? Yes ☐ No ☒ If yes, how much \_\_\_\_\_  
 Casing height above or below land surface below 36 in.

6 GROUT PLUG MATERIAL: ☐ Neat cement ☒ Cement grout ☒ Bentonite ☐ Other \_\_\_\_\_

Grout Plug Intervals: From 23 ft. to 3.5 ft., From 3.5 ft. to 2 ft., From 2 ft. to 0 ft.

What is the nearest source of possible contamination:  
☐ Septic tank ☐ Seepage pit ☒ Fuel storage ☐ Other (specify below)  
☐ Sewer lines ☐ Pit privy ☐ Fertilizer storage  
☐ Watertight sewer lines ☐ Sewage lagoon ☐ Insecticide storage  
☐ Lateral lines ☐ Feedyard ☐ Abandoned water well  
☐ Cess pool ☐ Livestock pens ☐ Oil well/Gas well

Direction from well? northwest  
 How many feet? approximately 15 ft.

FROM	TO	PLUGGING MATERIALS	FROM	TO	PLUGGING MATERIALS
87'	23'	Clean, coarse sand			Well plugged on 3/6/23 and 7/21/23.
23'	3.5'	Cement grout			
3.5'	2'	Bentonite Chips			Cement slab left around abandoned
2'	0'	Cement grout			well. Casing removed 3' below land
					surface.

7 CONTRACTOR'S OR LANDOWNER'S CERTIFICATION: This water well was plugged under my jurisdiction and was completed on (mo/day/year) 7/21/2023 and this record is true to the best of my knowledge and belief. Kansas Water Well Contractor's License No. \_\_\_\_\_ This Water Well Record was completed on (mo/day/year) 8/1/2023 under the business name of Gordon Bergkamp by (signature) Gordon Bergkamp

Send one white copy to Kansas Department of Health & Environment, Geology Section, 1000 SW Jackson Street, Ste. 420, Topeka, KS 66612-1367. Send one copy to WATER WELL OWNER and retain one for your records.

Visit us at <http://www.kdheks.gov/waterwell/index.html> Telephone 785-296-5524.

RECEIVED

KSA82a-1212

RECEIVED

Revised 1/20/2015

SEP 05 2023

AUG 14 2023

BUREAU OF WATER

EQUUS BEDS GMD #2