


**WATER WELL RECORD**

**Form WWC-5**

Division of Water Resources App. No.

<b>1 LOCATION OF WATER WELL:</b> County: <b>Finney</b>	Fraction <b>¼ SE ¼ SW ¼ NE ¼</b>	Section Number <b>4</b>	Township No. <b>T 23 S</b>	Range Number <b>R 32</b> <input type="checkbox"/> E <input checked="" type="checkbox"/> W
Street/Rural Address of Well Location; if unknown, distance & direction from nearest town or intersection: If at owner's address, check here <input type="checkbox"/> <b>Jennie Barker Rd. &amp; 6 Mile Rd. 1 1/2 Miles North, 1/8 Mile West, 300' North</b>		<b>Global Positioning System (GPS) information:</b> Latitude: ..... (in decimal degrees) Longitude: ..... (in decimal degrees) Elevation: ..... Datum: <input type="checkbox"/> WGS 84, <input type="checkbox"/> NAD 83, <input type="checkbox"/> NAD 27 Collection Method: <input type="checkbox"/> GPS unit (Make/Model: .....) <input type="checkbox"/> Digital Map/Photo, <input type="checkbox"/> Topographic Map, <input type="checkbox"/> Land Survey Est. Accuracy: <input type="checkbox"/> <3 m, <input type="checkbox"/> 3-5 m, <input type="checkbox"/> 5-15 m, <input type="checkbox"/> >15 m		
<b>2 WATER WELL OWNER:</b> <b>Mike Standley</b> RR#, Street Address, Box #: <b>14550 N. VFW Rd.</b> City, State, ZIP Code : <b>Garden City, KS 67846</b>				

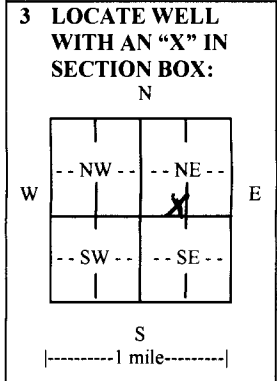

**4 DEPTH OF COMPLETED WELL** **180** ..... ft.

Depth(s) Groundwater Encountered (1)..... ft. (2)..... ft. (3)..... ft.

WELL'S STATIC WATER LEVEL **151** .....ft. below land surface measured on mo/day/yr.....

Pump test data: Well water was **159** .....ft. after **2** ..... hours pumping **25** ..... gpm

EST. YIELD **35** .....gpm. Well water was.....ft. after..... hours pumping..... gpm

Bore Hole Diameter **10** .....in. to **180** .....ft., and .....in. to .....ft.

WELL WATER TO BE USED AS:  Public water supply  Geothermal  Injection well  
 Domestic  Feedlot  Oil field water supply  Dewatering  Other (Specify below)  
 Irrigation  Industrial  Domestic-lawn & garden  Monitoring well **Stock Well**

Was a chemical/bacteriological sample submitted to Department?  Yes  No

If yes, mo/day/yr sample was submitted.....

Water well disinfected?  Yes  No

**5 TYPE OF CASING USED:**  Steel  PVC  Other .....

CASING JOINTS:  Glued  Clamped  Welded  Threaded

Casing diameter **.5** ..... in. to **180** ..... ft., Diameter ..... in. to ..... ft., Diameter ..... in. to ..... ft.

Casing height above land surface **18** ..... in., Weight **200** .....lbs./ft., Wall thickness or gauge No. **SDR21** .....

TYPE OF SCREEN OR PERFORATION MATERIAL:  
 Steel  Stainless Steel  PVC  Other (Specify) .....  
 Brass  Galvanized Steel  None used (open hole)

SCREEN OR PERFORATION OPENINGS ARE:  
 Continuous slot  Mill slot  Gauze wrapped  Torch cut  Drilled holes  None (open hole)  
 Louvered shutter  Key punched  Wire wrapped  Saw cut  Other (specify) .....

SCREEN-PERFORATED INTERVALS: From **160** ..... ft. to **180** ..... ft., From ..... ft. to ..... ft.  
From ..... ft. to ..... ft., From ..... ft. to ..... ft.

GRAVEL PACK INTERVALS: From **25** ..... ft. to **180** ..... ft., From ..... ft. to ..... ft.  
From ..... ft. to ..... ft., From ..... ft. to ..... ft.

**6 GROUT MATERIAL:**  Neat cement  Cement grout  Bentonite  Other .....

Grout Intervals: From **.5** ..... ft. to **25** ..... ft., From ..... ft. to ..... ft., From ..... ft. to ..... ft.

What is the nearest source of possible contamination:  
 Septic tank  Lateral lines  Pit privy  Livestock pens  Insecticide storage  Other (specify below)  
 Sewer lines  Cesspool  Sewage lagoon  Fuel storage  Abandoned water well  
 Watertight sewer lines  Seepage pit  Feedyard  Fertilizer storage  Oil well/gas well .....

Direction from well **West** ..... Distance from well **1/8 Mile** .....

FROM	TO	LITHOLOGIC LOG	FROM	TO	LITHO. LOG (cont.) or PLUGGING INTERVALS
0	2	Top Soil	158	162	Fine Sand, Few Small Brown Clay Str
2	42	Brown Clay	162	170	Fine to Medium Sand, Few Small
42	62	Brown Clay, Gypsum			Brown Clay Streaks
62	98	Medium Sand, Small Gravel, Brown Clay and Cemented Sand Streaks	170	174	Medium to Coarse Sand, Small Gravel
98	102	Cemented Sand	174	180	White Broken Rock (Loose)
102	121	Medium to Coarse Sand, Small Gravel			Yellow Soap Stone, White Broken
121	132	Soft Brown Clay, Few Sand Streaks			Rock Streaks
132	142	Medium to Coarse Sand, Small Gravel			
142	158	Brown Clay, Few Very Small Sand Str			

**7 CONTRACTOR'S OR LANDOWNER'S CERTIFICATION:** This water well was  constructed,  reconstructed, or  plugged under my jurisdiction and was completed on (mo/day/year) **6-19-14** ..... and this record is true to the best of my knowledge and belief. Kansas Water Well Contractor's License No. **532** ..... This Water Well Record was completed on (mo/day/year) **6-27-14** ..... under the business name of **Midwest Well & Pump Inc.** ..... by (signature) *[Signature]*

**INSTRUCTIONS:** Use typewriter or ball point pen. *PLEASE PRESS FIRMLY* and *PRINT* clearly. Please fill in blanks and check the correct answers. Send three copies (white, blue, pink) to Kansas Department of Health and Environment, Bureau of Water, Geology Section, 1000 SW Jackson St., Suite 420, Topeka, Kansas 66612-1367. Telephone 785-296-5522. Send one copy to WATER WELL OWNER and retain one for your records. Include fee of \$5.00 for each constructed well. Visit us at <http://www.kdheks.gov/waterwell/index.html>.