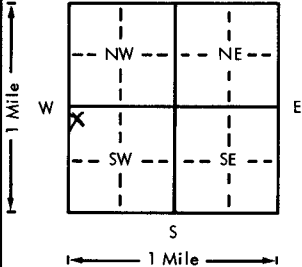


USE TYPEWRITER OR BALL  
POINT PEN-PRESS FIRMLY,  
PRINT CLEARLY.

WATER WELL RECORD  
KSA 82a-1201-1215

Kansas Department of Health and  
Environment-Division of Environment  
(Water well Contractors)  
Topeka, Kansas 66620

1. Location of well:		County <b>Finney</b>	Fraction <b>CCB</b> NW 1/4 SW 1/4 SW 1/4	Section number <b>25</b>	Township number <b>T 23 S</b>	Range number <b>R 33 E</b>
2. Distance and direction from nearest town or city: <b>1/2 west of Garden City on Hiway 50 to V.F.W. Rd., 4 1/2 miles North.</b>			3. Owner of well: <b>John Hawk</b> R.R. or street: <b>1306 N. Main</b> City, state, zip code: <b>Garden City, Ks. 67846</b>			
4. Locate with "X" in section below:		Sketch map:		6. Bore hole dia. <b>26</b> in. Completion date <b>6-13-77</b> Well depth <b>344</b> ft.		
				7. <input type="checkbox"/> Cable tool <input type="checkbox"/> Rotary <input type="checkbox"/> Driven <input type="checkbox"/> Dug <input type="checkbox"/> Hollow rod <input type="checkbox"/> Jetted <input type="checkbox"/> Bored <input checked="" type="checkbox"/> Reverse rotary		
5. Type and color of material		From	To	8. Use: <input type="checkbox"/> Domestic <input type="checkbox"/> Public supply <input type="checkbox"/> Industry <input checked="" type="checkbox"/> Irrigation <input type="checkbox"/> Air conditioning <input type="checkbox"/> Stock <input type="checkbox"/> Lawn <input type="checkbox"/> Oil field water <input type="checkbox"/> Other		
				9. Casing: Material <b>steel</b> Height: Above or below Threaded <input type="checkbox"/> Welded <input checked="" type="checkbox"/> Surface <b>12</b> in. RMP <input type="checkbox"/> PVC <input type="checkbox"/> Weight <b>36.87</b> lbs./ft. Dia. <b>16</b> in. to <b>345</b> ft. depth Wall Thickness: inches or Dia. <input type="checkbox"/> in. to <input type="checkbox"/> ft. depth gage No. <b>250</b>		
				10. Screen: Manufacturer's name <b>Johnson</b> Type <b>galv.</b> Dia. <b>16"</b> Slot/gauge <b>180-190</b> Length <b>10</b> ft. Set between <b>180-190</b> ft. and <b>320-330</b> ft. Perf: <b>150-180</b> ft. and <b>190-320, 330-340</b> ft. Gravel pack? <b>yes</b> Size range of material <b>1/2" down</b>		
				11. Static water level: <b>149</b> ft. below land surface Date <b>4-7-77</b>		
				12. Pumping level below land surfaces: <b>190</b> ft. after <b>2</b> hrs. pumping <b>1000</b> g.p.m. <b>209</b> ft. after <b>4</b> hrs. pumping <b>1350</b> g.p.m. Estimated maximum yield <b>1350</b> g.p.m.		
				13. Water sample submitted: <b>Yes</b> <input checked="" type="checkbox"/> No <input type="checkbox"/> Date		
				14. Well head completion: <b>12</b> inches above grade		
				15. Well grouted? <b>yes</b> With: <input type="checkbox"/> Neat cement <input type="checkbox"/> Bentonite <input checked="" type="checkbox"/> Concrete Depth: From <b>0</b> ft. to <b>10</b> ft.		
				16. Nearest source of possible contamination: <b>N/A</b> ft. <input type="checkbox"/> Direction <input type="checkbox"/> Type <input type="checkbox"/> Well disinfected upon completion? <input type="checkbox"/> Yes <input checked="" type="checkbox"/> No		
				17. Pump: <input type="checkbox"/> Not installed Manufacturer's name <input type="checkbox"/> Model number <input type="checkbox"/> HP <input type="checkbox"/> Volts <input type="checkbox"/> Length of drop pipe <input type="checkbox"/> ft. capacity <input type="checkbox"/> g.p.m. Type: <input type="checkbox"/> Submersible <input type="checkbox"/> Turbine <input type="checkbox"/> Jet <input type="checkbox"/> Reciprocating <input type="checkbox"/> Centrifugal <input type="checkbox"/> Other		
		(Use a second sheet if needed)				
18. Elevation:	19. Remarks: <b>Customer furnished pump.</b>			20. Water well contractor's certification: This well was drilled under my jurisdiction and this report is true to the best of my knowledge and belief. <b>Winter-Wilson Drilling Co. 208</b> Business name <b>Box A Garden City, Ks.</b> License No. <b>208</b> Address <b>Box A Garden City, Ks.</b> Signed <b>DeLesse</b> Date <b>7-25-77</b> Authorized representative		
Topography: <input type="checkbox"/> Hill <input checked="" type="checkbox"/> Slope <input type="checkbox"/> Upland <input type="checkbox"/> Valley						

Forward the white, blue and pink copies to the Department of Health and Environment

Form WWC-5

Phone 276-8269 • P.O. Box A • GARDEN CITY, KANSAS 67846

**JOHNNY HAWK  
 FINNEY COUNTY  
 3/10/77**

**Location:** SW 25-23-33 300 Ft. south of Existing well

**Static Water Level**

**Test #2**

0	1k	Top soil
1	21	Brown clay
21	30	Med. to coarse gravel
30	52	Brown clay
52	65	Brown clay and white rock (Tight)
65	92	Brown clay streaks of fine sand
92	110	Blue clay
110	140	Brown clay
140	157	Brown clay and white rock (Tight)
157	161	Fine to med. sand and gravel (Loose)
161	168	Fine to med. sand and gravel 15% clay (Tight) (Hard streak)
168	175	Brown clay (Tight)
175	191	Fine to med. sand and gravel (Loose)
191	196	Fine to med. sand and gravel 15% clay (Tight) (Hard Streaks)
196	200	Brown clay
200	207	Fine to med. sand and gravel 10% clay (Tight)
207	215	Fine to med. sand and gravel 15% clay (Loose)
215	243	Brown clay (Tight)
243	249	Brown sandy clay 30% fine to med. sand and fin gravel
249	260	Fine to med. sand and gravel streaks of clay 15% (Loose)
260	265	Fine to med. sand and gravel (Loose)
265	275	Brown clay
275	284	Fine to med. sand and gravel with white rock 10% clay (Tight)
284	304	Brown clay
304	309	Fine to med. sand and gravel (Loose)
309	319	Brown clay
319	335	Fine to med. sand and gravel with white rock (Loose)

Phone 276-8269 • P.O. Box A • GARDEN CITY, KANSAS 67846

335	341	Fine to med. sand and gravel with white rock (Loose) (small hard streaks)
341	350	Brown and yellow clay with white rock (Hard)