

2405

1 LOCATION OF WATER WELL: Fraction SE 1/4 SE 1/4 SW 1/4 Section Number 19 Township Number 23 Range Number 33 E/W
 County: Finney

Distance and direction from nearest town or city street address of well if located within city? From Holcomb, approx. 3 mi.
North & 1/4 mi. East

2 WATER WELL OWNER: Garden City Company

RR#, St. Address, Box #: PO Box 597

City, State, ZIP Code: Garden City, Ks, 67846

Global Positioning System (decimal degrees, min. of 4 digits)

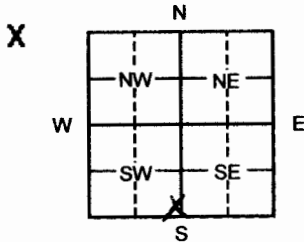
Latitude: _____

Longitude: _____

Elevation: _____

Datum: _____

Data Collection Method: _____

3 MARK WELL'S LOCATION WITH AN "X" IN SECTION BOX:**4 DEPTH OF WELL** 314 **ft.**WELL'S STATIC WATER LEVEL 141 **ft**

WELL WAS USED AS:

☐ 1 Domestic☒ 2 Irrigation☐ 3 Feedlot☐ 4 Industrial☐ 5 Public Water Supply☐ 6 Oil Field Water Supply☐ 7 Domestic (Lawn & Garden)☐ 8 Air Conditioning☐ 9 Dewatering☐ 10 Monitoring☐ 11 Injection Well☐ 12 Other _____Was a chemical/bacteriological sample submitted to Department? Yes ___ No x**5 TYPE OF BLANK CASING USED:**☒ 1 Steel
☐ 2 PVC☐ 3 RMP (SR)
☐ 4 ABS☐ 5 Wrought
☐ 6 Asbestos-Cement☐ 7 Fiberglass
☐ 8 Concrete Tile☐ 9 Other (Specify below) _____Blank casing diameter 16 in. Was casing pulled? Yes ___ No x If yes, how much _____Casing height above or below land surface -48 in.**6 GROUT PLUG MATERIAL:** ☐ 1 Neat cement ☒ 2 Cement grout ☐ 3 Bentonite ☐ 4 Other _____Grout Plug Intervals: From 4 ft. to 14 ft., From _____ ft. to _____ ft., From _____ to _____ ft.

What is the nearest source of possible contamination: None Observed

☐ 1 Septic tank☐ 6 Seepage pit☐ 11 Fuel Storage☐ 16 Other (specify below) _____☐ 2 Sewer lines☐ 7 Pit privy☐ 12 Fertilizer storage☐ 3 Watertight sewer lines☐ 8 Sewage lagoon☐ 13 Insecticide storage☐ 4 Lateral lines☐ 9 Feedyard☐ 14 Abandoned water well

Direction from well?

☐ 5 Cess pool☐ 10 Livestock pens☐ 15 Oil well/Gas well

How many feet?

FROM	TO	PLUGGING MATERIALS	FROM	TO	PLUGGING MATERIALS
0	4	Backfill			
4	14	Cement			
14	141	Clay			
141	314	Sand			

7 CONTRACTOR'S OR LANDOWNER'S CERTIFICATION: This water well was plugged under my jurisdiction and was completed on (mo/day/year) 11/25/08 and this record is true to the best of my knowledge and belief. Kansas Water Well Contractor's License No. 145. This Water Well Record was completed on (mo/day/year) 12/19/08 under the business name of Henkle Drilling & Supply Co., Inc. by (signature) Benny Ruchman.

INSTRUCTIONS: Please fill in blanks or circle the correct answers. Send top three copies to Kansas Department of Health and Environment, Bureau of Water, Geology Section, 1000 SW Jackson St., Ste. 420, Topeka, Kansas 66612-1367. Telephone: 785/296-5522. Send one to Water Well Owner and retain one for your records. Visit us at <http://www.kdheks.gov/waterwell>.