

CORRECTION(S) TO WATER WELL RECORD (WWC-5)

(to rectify lacking or incorrect information)

County:

Finney

Location listed as:

Section-Township-Range: 24-23S-33WFraction ($\frac{1}{4}$ $\frac{1}{4}$ $\frac{1}{4}$): SE

Location changed to:

34-23S-33WSE SE SE

Other changes: Initial statements: _____

Changed to: _____

Comments: _____

verification method: Wellsite address, area road map, Finney CountyAppraiser's online parcel search, and mapping tool & aerial
photos on KGS website.initials: DRK date: 4/20/2010

submitted by: Kansas Geological Survey, Data Resources Library, 1930 Constant Ave., Lawrence, KS 66047-3726

to: Kansas Dept of Health & Environment, Bureau of Water, 1000 SW Jackson, Suite 420, Topeka, KS 66612-1367.

1 LOCATION OF WATER WELL:	Fraction	Section Number	Township Number	Range Number
County: <u>Finney</u>	$\frac{1}{4}$ $\frac{1}{4}$ <u>SE</u> $\frac{1}{4}$	<u>24</u>	T <u>23</u> <u>S</u>	R <u>33</u> <u>E</u> <u>N</u>

Distance and direction from nearest town or city street address of well if located within city?

3655 N Anderson Rd.

2 WATER WELL OWNER:

RR#, St. Address, Box # :

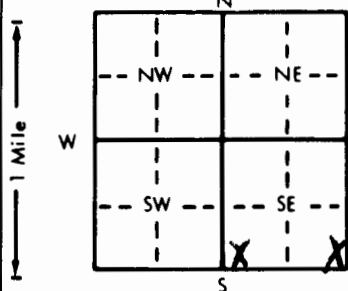
City, State, ZIP Code :

Don Novack
3655 N Anderson Rd.
Garden City, KS 67846

Board of Agriculture, Division of Water Resources

Application Number:

3 LOCATE WELL'S LOCATION WITH AN "X" IN SECTION BOX:

4 DEPTH OF COMPLETED WELL: 30.7 ft. ELEVATION:

Depth(s) Groundwater Encountered 1. ft. 2. ft. 3. ft.

WELL'S STATIC WATER LEVEL 12.0 ft. below land surface measured on mo/day/yr 3-1-09

Pump test data: Well water was ft. after hours pumping gpm

Est. Yield gpm: Well water was ft. after hours pumping gpm

Bore Hole Diameter 9 7/8 in. to 3.20 ft. and in. to ft.

WELL WATER TO BE USED AS: 5 Public water supply 8 Air conditioning 11 Injection well

1 Domestic 3 Feedlot 6 Oil field water supply 9 Dewatering 12 Other (Specify below)

2 Irrigation 4 Industrial 7 Lawn and garden only 10 Monitoring well

Was a chemical/bacteriological sample submitted to Department? Yes No X; If yes, mo/day/yr sample was submittedWater Well Disinfected? Yes X No

5 TYPE OF BLANK CASING USED:

1 Steel 3 RMP (SR)

5 Wrought iron

8 Concrete tile

CASING JOINTS: Glued X Clamped

6 Asbestos-Cement

9 Other (specify below)

Welded

7 Fiberglass

Threaded

2 PVC

5 ABS

Blank casing diameter 5 in. to 28.7 ft. Dia. in. to ft. Dia. in. to ft.Casing height above land surface 18 in. weight 50 R 17 lbs./ft. Wall thickness or gauge No. 250

TYPE OF SCREEN OR PERFORATION MATERIAL:

1 Steel 3 Stainless steel

5 Fiberglass

PVC

10 Asbestos-cement

2 Brass 4 Galvanized steel

6 Concrete tile

8 RMP (SR)

11 Other (specify)

9 ABS

12 None used (open hole)

SCREEN OR PERFORATION OPENINGS ARE:

1 Continuous slot

3 Mill slot

5 Gauzed wrapped

Saw cut

11 None (open hole)

2 Louvered shutter

4 Key punched

6 Wire wrapped

9 Drilled holes

7 Torch cut

10 Other (specify)

SCREEN-PERFORATED INTERVALS: From 28.7 ft. to 30.7 ft. From ft. to ft.

From ft. to ft. From ft. to ft.

GRAVEL PACK INTERVALS: From 28.0 ft. to 30.7 ft. From ft. to ft.

From ft. to ft. From ft. to ft.

6 GROUT MATERIAL:

1 Neat cement

2 Cement grout

3 Bentonite

4 Other

Grout Intervals: From 28.0 ft. to 25.0 ft. From 4 ft. to 35 ft. From ft. to ft.

What is the nearest source of possible contamination:

1 Septic tank

4 Lateral lines

7 Pit privy

10 Livestock pens

14 Abandoned water well

2 Sewer lines

5 Cess pool

8 Sewage lagoon

11 Fuel storage

15 Oil well/Gas well

3 Watertight sewer lines

6 Seepage pit

9 Feedyard

12 Fertilizer storage

16 Other (specify below)

13 Insecticide storage

Field

Direction from well?

How many feet?

FROM	TO	LITHOLOGIC LOG	FROM	TO	PLUGGING INTERVALS
0	7	Top Soil	213	231	Fine to med Sand & gravel
7	15	Brown Sandy Clay	231	243	Brown Sandy clay
15	26	Fine to med Sand & gravel	243	251	Fine to med Sand & gravel
26	73	Brown Sandy clay	251	292	Brown Sandy clay
73	80	Fine to med Sand & gravel	292	305	Fine to med Sand & gravel
80	129	Brown Sandy clay	305	310	Brown Sandy clay
129	133	Hard Rock	310	312	Real fine Sand
133	157	Brown clay	312	320	Brown clay
157	161	Hard Rock			
161	177	Brown Sandy clay			
177	195	Fine to med Sand & gravel			
195	203	Brown Sandy clay			
203	210	Fine to med Sand & gravel			
210	213	Brown Sandy clay			

7 CONTRACTOR'S OR LANDOWNER'S CERTIFICATION: This water well was (1) constructed, (2) reconstructed, or (3) plugged under my jurisdiction and was completed on (mo/day/year) 3-1-09 and this record is true to the best of my knowledge and belief. KansasWater Well Contractor's License No. 172 This Water Well Record was completed on (mo/day/yr) 3-3-09under the business name of Tanager Water Well Service LLC by (signature) Novack