

7,193-D5

**1 LOCATION OF WATER WELL:** Fraction NW ¼ NW ¼ SE ¼ Section Number 20 Township Number 23 Range Number 34 E/W  
 County: Finney

Distance and direction from nearest town or city street address of well if located within city? From Holcomb, approx. 1 mi. North, 4 mi. West, 2 ½ mi. North, & ½ mi. West.

**2 WATER WELL OWNER:** Garden City Company

RR#, St. Address, Box #: PO Box 597

City, State, ZIP Code: Garden City, Ks, 67846

**Global Positioning System** (decimal degrees, min. of 4 digits)

Latitude: \_\_\_\_\_


Longitude: \_\_\_\_\_

Elevation: \_\_\_\_\_

Datum: \_\_\_\_\_

Data Collection Method: \_\_\_\_\_

**3 MARK WELL'S LOCATION WITH AN "X" IN SECTION BOX:**

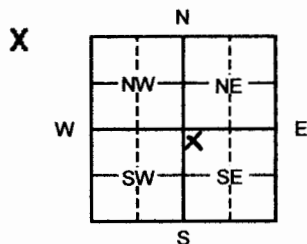

**4 DEPTH OF WELL** 293 ft.

WELL'S STATIC WATER LEVEL 135 ft

WELL WAS USED AS:

☐ 1 Domestic

☒ 2 Irrigation

☐ 3 Feedlot

☐ 4 Industrial

☐ 5 Public Water Supply

☐ 6 Oil Field Water Supply

☐ 7 Domestic (Lawn & Garden)

☐ 8 Air Conditioning

☐ 9 Dewatering

☐ 10 Monitoring

☐ 11 Injection Well

☐ 12 Other \_\_\_\_\_

Was a chemical/bacteriological sample submitted to Department? Yes \_\_\_ No x

**5 TYPE OF BLANK CASING USED:**

☒ 1 Steel

☐ 3 RMP (SR)

☐ 5 Wrought

☐ 7 Fiberglass

☐ 9 Other (Specify below) \_\_\_\_\_

☐ 2 PVC

☐ 4 ABS

☐ 6 Asbestos-Cement

☐ 8 Concrete Tile

Blank casing diameter 16 in. Was casing pulled? Yes \_\_\_ No x If yes, how much \_\_\_\_\_

Casing height above or below land surface -48 in.

**6 GROUT PLUG MATERIAL:** ☐ 1 Neat cement ☒ 2 Cement grout ☐ 3 Bentonite ☐ 4 Other \_\_\_\_\_

Grout Plug Intervals: From 4 ft. to 14 ft., From \_\_\_\_\_ ft. to \_\_\_\_\_ ft., From \_\_\_\_\_ to \_\_\_\_\_ ft.

What is the nearest source of possible contamination: None Observed

☐ 1 Septic tank

☐ 6 Seepage pit

☐ 11 Fuel Storage

☐ 16 Other (specify below) \_\_\_\_\_

☐ 2 Sewer lines

☐ 7 Pit privy

☐ 12 Fertilizer storage

☐ 3 Watertight sewer lines

☐ 8 Sewage lagoon

☐ 13 Insecticide storage

☐ 4 Lateral lines

☐ 9 Feedyard

☐ 14 Abandoned water well

Direction from well?

☐ 5 Cess pool

☐ 10 Livestock pens

☐ 15 Oil well/Gas well

How many feet?

FROM	TO	PLUGGING MATERIALS	FROM	TO	PLUGGING MATERIALS
0	4	Backfill			
4	14	Cement			
14	135	Clay			
135	293	Sand			

**7 CONTRACTOR'S OR LANDOWNER'S CERTIFICATION:** This water well was plugged under my jurisdiction and was completed on (mo/day/year) 11/25/08 and this record is true to the best of my knowledge and belief. Kansas Water Well Contractor's License No. 145. This Water Well Record was completed on (mo/day/year) 12/19/08 under the business name of Henkle Drilling & Supply Co., Inc. by (signature) Brian Ruckert.

**INSTRUCTIONS:** Please fill in blanks or circle the correct answers. Send top three copies to Kansas Department of Health and Environment, Bureau of Water, Geology Section, 1000 SW Jackson St., Ste. 420, Topeka, Kansas 66612-1367. Telephone: 785/296-5522. Send one to Water Well Owner and retain one for your records. Visit us at <http://www.kdheks.gov/waterwell>.