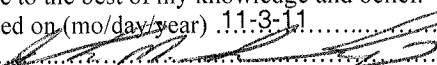


WATER WELL RECORD

Form WWC-5

Division of Water Resources App. No.

1 LOCATION OF WATER WELL: County: Finney County		Fraction ¼ SW ¼ NE ¼ NE ¼	Section Number 18	Township No. T 23 S	Range Number R 34 <input type="checkbox"/> E <input checked="" type="checkbox"/> W																
Street/Rural Address of Well Location; if unknown, distance & direction from nearest town or intersection: If at owner's address, check here <input type="checkbox"/> Lowe Rd. & Byrd Rd. 1 3/4 Mile North on Byrd Rd., 1300' West			Global Positioning System (GPS) information: Latitude: (in decimal degrees) Longitude: (in decimal degrees) Elevation: Datum: <input type="checkbox"/> WGS 84, <input type="checkbox"/> NAD 83, <input type="checkbox"/> NAD 27 Collection Method: <input type="checkbox"/> GPS unit (Make/Model:) <input type="checkbox"/> Digital Map/Photo, <input type="checkbox"/> Topographic Map, <input type="checkbox"/> Land Survey Est. Accuracy: <input type="checkbox"/> <3 m, <input type="checkbox"/> 3-5 m, <input type="checkbox"/> 5-15 m, <input type="checkbox"/> >15 m																		
2 WATER WELL OWNER: Garden City Company RR#, Street Address, Box #: PO Box 597 City, State, ZIP Code : Garden City, KS 67846																					
3 LOCATE WELL WITH AN "X" IN SECTION BOX: N <table border="1" style="width: 100%; text-align: center; border-collapse: collapse;"> <tr><td>W</td><td>NW</td><td>NE</td><td>E</td></tr> <tr><td></td><td></td><td>X</td><td></td></tr> <tr><td></td><td>SW</td><td>SE</td><td></td></tr> <tr><td></td><td></td><td></td><td></td></tr> </table> S -----1 mile-----		W	NW	NE	E			X			SW	SE						4 DEPTH OF COMPLETED WELL 305 ft. Depth(s) Groundwater Encountered (1)..... ft. (2)..... ft. (3)..... ft. WELL'S STATIC WATER LEVEL.....176'.....ft. below land surface measured on mo/day/yr..... Pump test data: Well water was 200.....ft. after 3..... hours pumping 44..... gpm EST. YIELD 125.....gpm. Well water was.....ft. after..... hours pumping..... gpm Bore Hole Diameter 10.....in. to 305.....ft., andin. toft. WELL WATER TO BE USED AS: <input type="checkbox"/> Public water supply <input type="checkbox"/> Geothermal <input type="checkbox"/> Injection well <input checked="" type="checkbox"/> Domestic <input type="checkbox"/> Feedlot <input type="checkbox"/> Oil field water supply <input type="checkbox"/> Dewatering <input type="checkbox"/> Other (Specify below) <input type="checkbox"/> Irrigation <input type="checkbox"/> Industrial <input type="checkbox"/> Domestic-lawn & garden <input type="checkbox"/> Monitoring well Was a chemical/bacteriological sample submitted to Department? <input type="checkbox"/> Yes <input checked="" type="checkbox"/> No If yes, mo/day/yr sample was submitted..... Water well disinfected? <input checked="" type="checkbox"/> Yes <input type="checkbox"/> No			
W	NW	NE	E																		
		X																			
	SW	SE																			
5 TYPE OF CASING USED: <input type="checkbox"/> Steel <input checked="" type="checkbox"/> PVC <input type="checkbox"/> Other CASING JOINTS: <input checked="" type="checkbox"/> Glued <input type="checkbox"/> Clamped <input type="checkbox"/> Welded <input type="checkbox"/> Threaded Casing diameter 5..... in. to 265..... ft., Diameter in. to ft., Diameter in. to ft. Casing height above land surface 18..... in., Weight 200.....lbs./ft., Wall thickness or gauge No. sdr21..... TYPE OF SCREEN OR PERFORATION MATERIAL: <input type="checkbox"/> Steel <input type="checkbox"/> Stainless Steel <input checked="" type="checkbox"/> PVC <input type="checkbox"/> Other (Specify) <input type="checkbox"/> Brass <input type="checkbox"/> Galvanized Steel <input type="checkbox"/> None used (open hole) SCREEN OR PERFORATION OPENINGS ARE: <input type="checkbox"/> Continuous slot <input type="checkbox"/> Mill slot <input type="checkbox"/> Gauze wrapped <input type="checkbox"/> Torch cut <input type="checkbox"/> Drilled holes <input type="checkbox"/> None (open hole) <input type="checkbox"/> Louvered shutter <input type="checkbox"/> Key punched <input type="checkbox"/> Wire wrapped <input checked="" type="checkbox"/> Saw cut <input type="checkbox"/> Other (specify) SCREEN-PERFORATED INTERVALS: From 265..... ft. to 305..... ft., From ft. to ft. From ft. to ft., From ft. to ft. GRAVEL PACK INTERVALS: From 25..... ft. to 145..... ft., From ft. to ft. From 165..... ft. to 305..... ft., From ft. to ft.																					
6 GROUT MATERIAL: <input type="checkbox"/> Neat cement <input type="checkbox"/> Cement grout <input checked="" type="checkbox"/> Bentonite <input type="checkbox"/> Other Grout Intervals: From 5..... ft. to 25..... ft., From 145..... ft. to 165..... ft., From ft. to ft. What is the nearest source of possible contamination: <input checked="" type="checkbox"/> Septic tank <input type="checkbox"/> Lateral lines <input type="checkbox"/> Pit privy <input type="checkbox"/> Livestock pens <input type="checkbox"/> Insecticide storage <input type="checkbox"/> Other (specify below) <input type="checkbox"/> Sewer lines <input type="checkbox"/> Cesspool <input type="checkbox"/> Sewage lagoon <input type="checkbox"/> Fuel storage <input type="checkbox"/> Abandoned water well <input type="checkbox"/> Watertight sewer lines <input type="checkbox"/> Seepage pit <input type="checkbox"/> Feedyard <input type="checkbox"/> Fertilizer storage <input type="checkbox"/> Oil well/gas well Direction from well North East..... Distance from well 110'.....																					
FROM	TO	LITHOLOGIC LOG	FROM	TO	LITHO. LOG (cont.) or PLUGGING INTERVALS																
0	2	Top Soil			Brown Clay Streaks																
2	60	Brown Clay	237	255	Medium Sand, Brown Clay and Cem.																
60	65	Fine Sand			Streaks																
65	85	Brown Clay, Fine Sand Streaks	255	280	Medium to Coarse Sand, Small Gravel																
85	124	Sandy Brown Clay, Gypsum, Cem.Sand			White Broken Rock Chips																
124	145	Medium Sand, Brown Clay Streaks	280	289	Brown Clay																
145	160	Brown Clay	289	303	Fine to Medium Sand, White Broken																
160	165	Brown Clay, Coarse Sand Streaks			Rock Chips																
165	176	Brown Clay	303	305	Gray Shale																
176	237	Medium to Coarse Sand, small Gravel																			
7 CONTRACTOR'S OR LANDOWNER'S CERTIFICATION: This water well was <input checked="" type="checkbox"/> constructed, <input type="checkbox"/> reconstructed, or <input type="checkbox"/> plugged under my jurisdiction and was completed on (mo/day/year) 10-26-11..... and this record is true to the best of my knowledge and belief. Kansas Water Well Contractor's License No. 532..... This Water Well Record was completed on (mo/day/year) 11-3-11..... under the business name of Midwest Well & Pump Inc..... by (signature) 																					
INSTRUCTIONS: Use typewriter or ball point pen. PLEASE PRESS FIRMLY and PRINT clearly. Please fill in blanks and check the correct answers. Send three copies (white, blue, pink) to Kansas Department of Health and Environment, Bureau of Water, Geology Section, 1000 SW Jackson St., Suite 420, Topeka, Kansas 66612-1367. Telephone 785-296-5522. Send one copy to WATER WELL OWNER and retain one for your records. Include fee of \$5.00 for each constructed well. Visit us at http://www.kdheks.gov/waterwell/index.html .																					