

WATER WELL PLUGGING RECORD Form WWC-5P

KSA 82a-1212 ID NO.

7193-DB

1 LOCATION OF WATER WELL: County: Finney	Fraction 1/4 1/4 1/4 NW 1/4	Section Number 33	Township Number T 23 S	Range Number 34 <input type="checkbox"/> E <input checked="" type="checkbox"/> W
--	--------------------------------	----------------------	---------------------------	---

Street/Rural Address of Well Location; if unknown, distance & direction from nearest town or intersection: If at owner's address, check here ☐ From Holcomb Ks. approx. 1 mile north

4 miles west, 1/2 mile north, 1/4 mile east

Global Positioning Systems (GPS) information:

Latitude: 38.01365 (in decimal degrees)

Longitude: 101.06310 (in decimal degrees)

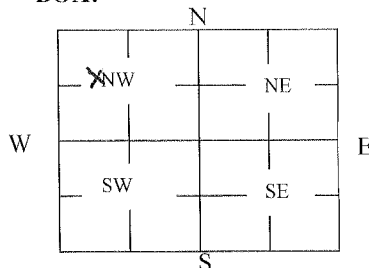
Elevation:

Datum: ☐ WGS84, ☐ NAD83, ☒ NAD27

Collection Method:

☒ GPS unit (Make/Model: Megellan eXplorist GC☐ Digital Map/Photo, ☐ Topographic Map, ☐ Land SurveyEst. Accuracy: ☐ < 3 m, ☐ 3-5 m, ☐ 5-15 m, ☐ > 15 m

2 WATER WELL OWNER: The Garden City Company
RR#, St. Address, Box #: P.O. Box 597
City, State ZIP Code: Garden City Ks. 678460597

3 MARK WELL'S LOCATION WITH AN "X" IN SECTION BOX:**4 DEPTH OF WELL** 342 **ft.**WELL'S STATIC WATER LEVEL 164 **ft.**

WELL WAS USED AS:

☐ Domestic
☒ Irrigation
☐ Feedlot
☐ Industrial

☐ Public Water Supply
☐ Oil Field Water Supply
☐ Domestic (Lawn & Garden)
☐ Air Conditioning

☐ Dewatering
☐ Monitoring
☐ Injection Well
☐ Other

Was a chemical/bacteriological sample submitted to Department? Yes ☐ No ☒**5 TYPE OF BLANK CASING USED:**

☒ Steel
☐ PVC

☐ RMP (SR)
☐ ABS

☐ Wrought
☐ Asbestos-Cement

☐ Fiberglass
☐ Concrete Tile

☐ Other (Specify below)Blank casing diameter 16 in. Was casing pulled? Yes ☒ No ☐ If yes, how much 60"

Casing height above or below land surface Below 60 in.

6 GROUT PLUG MATERIAL: ☐ Neat cement ☒ Cement grout ☐ Bentonite ☐ Other

Grout Plug Intervals: From 6 ft. to 10 ft., From _____ ft. to _____ ft., From _____ to _____ ft.

What is the nearest source of possible contamination:

☐ Septic tank
☐ Sewer lines
☐ Watertight sewer lines
☐ Lateral lines
☐ Cess pool

☐ Seepage pit
☐ Pit privy
☐ Sewage lagoon
☐ Feedyard
☐ Livestock pens

☐ Fuel Storage
☐ Fertilizer storage
☐ Insecticide storage
☐ Abandoned water well
☐ Oil well/Gas well

☒ Other (specify below)

None Observed

Direction from well?

How many feet?

FROM	TO	PLUGGING MATERIALS	FROM	TO	PLUGGING MATERIALS
342'	164'	Chlorinated Road Sand	164'	10'	Dirty Oversized Rock w/clay chunks
10'	6'	3,000 PSI Concrete	10'	0'	Dug down, cut off casing, backfill

7 CONTRACTOR'S OR LANDOWNER'S CERTIFICATION: This water well was plugged under my jurisdiction and was completed on (mo/day/year) 6-15-2012 and this record is true to the best of my knowledge and belief. Kansas Water Well Contractor's License No. 145. This Water Well Record was completed on (mo/day/year) 6-22-2012 under the business name of Hydro Resources Mid Continent by (signature) Gary Clepper

INSTRUCTIONS: Use typewriter or ballpoint pen. Please press firmly and print clearly. Please fill in blanks, underline or circle the correct answers. Send top three copies to Kansas Department of Health and Environment, Bureau of Water, Geology Section, 1000 SW Jackson St., Ste. 420, Topeka, Kansas 66612-1367. Telephone: 785/296-5524. Send one to Water Well Owner and retain one for your records. Visit us at <http://www.kdheks.gov/waterwell/index.html>.

Check one: ☐ White Copy ☐ Blue Copy ☐ Pink Copy