

WATER WELL PLUGGING RECORD Form WWC-5P

KSA 82a-1212

ID NO.

23506-00

1 LOCATION OF WATER WELL: County: <u>Finney</u>	Fraction <u>1/4 SE 1/4 NW 1/4 SW 1/4</u>	Section Number <u>1</u>	Township Number <u>T 23 S</u>	Range Number <u>34</u> <input type="checkbox"/> E <input checked="" type="checkbox"/> W
---	---	----------------------------	----------------------------------	--

Street/Rural Address of Well Location; if unknown, distance & direction from nearest town or intersection: If at owner's address, check here ☐ Big Lowe Rd, and 7 Mlle Rd

1657 feet North, 4018 feet West

Global Positioning Systems (GPS) information:

Latitude: -101.00637493 (in decimal degrees)

Longitude: 38.08073721 (in decimal degrees)

Elevation:

Datum: ☐ WGS84, ☐ NAD83, ☐ NAD27

Collection Method:


☐ GPS unit (Make/Model: _____)

☐ Digital Map/Photo, ☐ Topographic Map, ☐ Land Survey

Est. Accuracy: ☐ < 3 m, ☐ 3-5 m, ☐ 5-15 m, ☐ > 15 m

2 WATER WELL OWNER: Roger G & Randal Unruh
RR#, St. Address, Box #: 625 S Cowgill Dr
City, State ZIP Code: Garden City, KS 67846

3 MARK WELL'S LOCATION WITH AN "X" IN SECTION BOX:

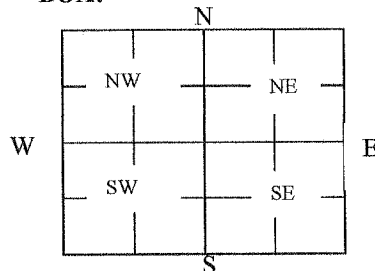

4 DEPTH OF WELL 305 ft.

WELL'S STATIC WATER LEVEL 193.5 ft

WELL WAS USED AS:

☐ Domestic
☒ Irrigation
☐ Feedlot
☐ Industrial

☐ Public Water Supply
☐ Oil Field Water Supply
☐ Domestic (Lawn & Garden)
☐ Air Conditioning

☐ Dewatering
☐ Monitoring
☐ Injection Well
☐ Other _____

Was a chemical/bacteriological sample submitted to Department? Yes ☐ No ☒

5 TYPE OF BLANK CASING USED:

☒ Steel ☐ RMP (SR) ☐ Wrought ☐ Fiberglass ☐ Other (Specify below)
☐ PVC ☐ ABS ☐ Asbestos-Cement ☐ Concrete Tile

Blank casing diameter 16 in. Was casing pulled? Yes ☐ No ☒ If yes, how much _____
Casing height above or below land surface 60" in.

6 GROUT PLUG MATERIAL: ☐ Neat cement ☐ Cement grout ☒ Bentonite ☐ Other _____

Grout Plug Intervals: From 5 ft. to 10 ft., From _____ ft. to _____ ft., From _____ to _____ ft.

What is the nearest source of possible contamination:

☐ Septic tank ☐ Seepage pit ☐ Fuel Storage ☐ Other (specify below)
☐ Sewer lines ☐ Pit privy ☐ Fertilizer storage
☐ Watertight sewer lines ☐ Sewage lagoon ☐ Insecticide storage
☐ Lateral lines ☐ Feedyard ☐ Abandoned water well
☐ Cess pool ☐ Livestock pens ☒ Oil well/Gas well

Direction from well? southwest

How many feet? 1000 ft approx.

FROM	TO	PLUGGING MATERIALS	FROM	TO	PLUGGING MATERIALS
0	5	Top Soil			
5	10	Bentonite			
10	185	Sand, Clay, Bentonite			
185	305	Washed Sand			

7 CONTRACTOR'S OR LANDOWNER'S CERTIFICATION: This water well was plugged under my jurisdiction and was completed on (mo/day/year) 04/08/2013 and this record is true to the best of my knowledge and belief. Kansas Water Well Contractor's License No. _____. This Water Well Record was completed on (mo/day/year) 04/09/2013 under the business name of Roger Unruh (land owner) by (signature) Roger Unruh

INSTRUCTIONS: Use typewriter or ballpoint pen. Please press firmly and print clearly. Please fill in blanks, underline or circle the correct answers. Send top three copies to Kansas Department of Health and Environment, Bureau of Water, Geology Section, 1000 SW Jackson St., Ste. 420, Topeka, Kansas 66612-1367. Telephone: 785/296-5524. Send one to Water Well Owner and retain one for your records. Visit us at <http://www.kdheks.gov/waterwell/index.html>.

Check one: ☒ White Copy ☐ Blue Copy ☐ Pink Copy