


1 LOCATION OF WATER WELL: Fraction NW 1/4 SW 1/4 NW 1/4 Section Number 35 Township Number T 23S S Range Number R 35W **7W**
 County: **KEARNEY**

Distance and direction from nearest town or city street address of well if located within city?

2 MILES NORTH OF DEERFIELD

2 WATER WELL OWNER: **OXY USA, INC** #3D BECKETT "A"
 RR#, St. Address, Box #: **P.O. BOX 26100** Board of Agriculture, Division of Water Resources
 City, State, ZIP Code: **OKLAHOMA CITY, OK 73126-0100** Application Number: **930496**

3 LOCATE WELL'S LOCATION WITH AN "X" IN SECTION BOX:

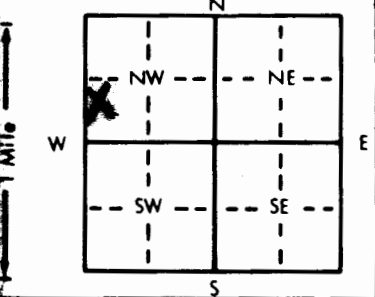

4 DEPTH OF COMPLETED WELL... **400** ft. ELEVATION:
 Depth(s) Groundwater Encountered 1. ft. 2. ft. 3. ft.
 WELL'S STATIC WATER LEVEL... **140** ft. below land surface measured on mo/day/yr **11-16-94**
 Pump test data: Well water was ft. after hours pumping gpm
 Est. Yield gpm: Well water was ft. after hours pumping gpm
 Bore Hole Diameter..... in. to ft., and..... in. to ft.
 WELL WATER TO BE USED AS: 5 Public water supply 8 Air conditioning 11 Injection well
 1 Domestic 3 Feedlot **9** Oil field water supply 9 Dewatering 12 Other (Specify below)
 2 Irrigation 4 Industrial **7** Lawn and garden only 10 Monitoring well
 Was a chemical/bacteriological sample submitted to Department? Yes.....No.....; If yes, mo/day/yr sample was submitted
 Water Well Disinfected? Yes No

5 TYPE OF BLANK CASING USED: 5 Wrought iron 8 Concrete tile CASING JOINTS: Glued Clamped
 1 Steel 3 RMP (SR) 6 Asbestos-Cement 9 Other (specify below) Welded
3 PVC 4 ABS 7 Fiberglass Threaded.....

Blank casing diameter... **5** in. to **400** ft., Dia..... in. to ft., Dia..... in. to ft.
 Casing height above land surface... **5' BELOW** in., weight..... lbs./ft. Wall thickness or gauge No.

TYPE OF SCREEN OR PERFORATION MATERIAL: 7 PVC 10 Asbestos-cement
 1 Steel 3 Stainless steel 5 Fiberglass 8 RMP (SR) 11 Other (specify)
 2 Brass 4 Galvanized steel 6 Concrete tile 9 ABS 12 None used (open hole)

SCREEN OR PERFORATION OPENINGS ARE: 5 Gauzed wrapped 8 Saw cut 11 None (open hole)
 1 Continuous slot 3 Mill slot 6 Wire wrapped 9 Drilled holes
 2 Louvered shutter 4 Key punched 7 Torch cut 10 Other (specify)

SCREEN-PERFORATED INTERVALS: From..... ft. to ft., From..... ft. to ft.
 From..... ft. to ft., From..... ft. to ft.
 GRAVEL PACK INTERVALS: From..... ft. to ft., From..... ft. to ft.
 From..... ft. to ft., From..... ft. to ft.

6 GROUT MATERIAL: 1 Neat cement **3** Cement grout 3 Bentonite 4 Other
 Grout Intervals: From..... **8** ft. to **5** ft., From..... ft. to ft., From..... ft. to ft.

What is the nearest source of possible contamination:
 1 Septic tank 4 Lateral lines 7 Pit privy 10 Livestock pens 14 Abandoned water well
 2 Sewer lines 5 Cess pool 8 Sewage lagoon 11 Fuel storage **15** Oil well/Gas well
 3 Watertight sewer lines 6 Seepage pit 9 Feedyard 12 Fertilizer storage 16 Other (specify below)
 13 Insecticide storage
 Direction from well? How many feet?

FROM	TO	LITHOLOGIC LOG	FROM	TO	PLUGGING INTERVALS
			400	140	CHLORINATED GRAVEL
			140	130	HOLE PLUG
			130	28	COMPACTED CLAY
			28	8	HOLE PLUG
			8	5	CEMENT GROUT
			5	0	BACKFILL

7 CONTRACTOR'S OR LANDOWNER'S CERTIFICATION: This water well was (1) constructed, (2) reconstructed, or **3** plugged under my jurisdiction and was completed on (mo/day/year) **11-16-94** and this record is true to the best of my knowledge and belief. Kansas Water Well Contractor's License No. **KWNCI-430** This Water Well Record was completed on (mo/day/year) **11-16-94** under the business name of **HOWARD DRIG.CO.BOX 806 BEAVER,OK 73932** by (signature) *Howard*