


1 LOCATION OF WATER WELL: Fraction NW 1/4 SW 1/4 NW 1/4 Section Number 35 Township Number T 23S S Range Number R 35W EW

2 MILES NORTH OF DEERFIELD
 2 WATER WELL OWNER: OXY USA, INC. #3D BECKETT A
 RR#, St. Address, Box #: P.O. BOX 26100 Board of Agriculture, Division of Water Resources
 City, State, ZIP Code: OKLAHOMA CITY, OK 73126-0100 Application Number: #930496

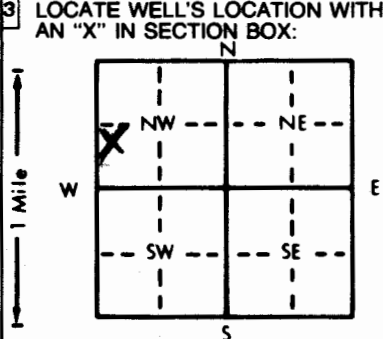

4 DEPTH OF COMPLETED WELL: 400 ft. ELEVATION:
 Depth(s) Groundwater Encountered 1. 140 ft. 2. ft. 3. ft.
 WELL'S STATIC WATER LEVEL: 140 ft. below land surface measured on mo/day/yr 11-23-93
 Pump test data: Well water was 160 ft. after 1 hours pumping 100 gpm
 Est. Yield 100 gpm: Well water was ft. after hours pumping gpm
 Bore Hole Diameter: 9 1/2 in. to 400 ft., and in. to ft.
 WELL WATER TO BE USED AS:
 1 Domestic 3 Feedlot 6 Oil field water supply 9 Dewatering 12 Other (Specify below)
 2 Irrigation 4 Industrial 7 Lawn and garden only 10 Monitoring well
 5 Public water supply 8 Air conditioning 11 Injection well
 Was a chemical/bacteriological sample submitted to Department? Yes.....No...X.....; If yes, mo/day/yr sample was submitted
 Water Well Disinfected? Yes X No

5 TYPE OF BLANK CASING USED:
 1 Steel 3 RMP (SR) 5 Wrought iron 8 Concrete tile CASING JOINTS: Glued X Clamped
 2 PVC 4 ABS 6 Asbestos-Cement 9 Other (specify below) Welded
 7 Fiberglass Threaded
 Blank casing diameter 5 in. to 400 ft., Dia in. to ft., Dia in. to ft.
 Casing height above land surface 24 in., weight 2,902 lbs./ft. Wall thickness or gauge No. 280 SDR 21
 TYPE OF SCREEN OR PERFORATION MATERIAL:
 1 Steel 3 Stainless steel 5 Fiberglass 7 PVC 8 RMP (SR) 10 Asbestos-cement 11 Other (specify)
 2 Brass 4 Galvanized steel 6 Concrete tile 9 ABS 12 None used (open hole)
 SCREEN OR PERFORATION OPENINGS ARE:
 1 Continuous slot 3 Mill slot 5 Gauzed wrapped 8 Saw cut 11 None (open hole)
 2 Louvered shutter 4 Key punched 6 Wire wrapped 9 Drilled holes
 7 Torch cut 10 Other (specify)
 SCREEN-PERFORATED INTERVALS: From 300 ft. to 400 ft., From ft. to ft.
 From ft. to ft., From ft. to ft.
 GRAVEL PACK INTERVALS: From 250 ft. to 400 ft., From ft. to ft.
 From ft. to ft., From ft. to ft.

6 GROUT MATERIAL: 1 Neat cement 2 Cement grout 3 Bentonite 4 Other hole plug
 Grout Intervals: From 1 ft. to 20 ft., From ft. to ft., From ft. to ft.
 What is the nearest source of possible contamination:
 1 Septic tank 4 Lateral lines 7 Pit privy 10 Livestock pens 14 Abandoned water well
 2 Sewer lines 5 Cess pool 8 Sewage lagoon 11 Fuel storage 15 Oil well/Gas well
 3 Watertight sewer lines 6 Seepage pit 9 Feedyard 12 Fertilizer storage 16 Other (specify below)
 13 Insecticide storage
 Direction from well? SOUTH How many feet? 100'

FROM	TO	LITHOLOGIC LOG	FROM	TO	PLUGGING INTERVALS
0	15	TOP SOIL			
15	75	SANDY CLAY			
75	98	COARSE SAND & GRAVEL			
98	100	CLAY			
100	160	SANDY CLAY			
160	198	FINE TO COARSE SAND & GRAVEL			
198	230	SANDY CLAY			
230	290	FINE TO COARSE SAND & GRAVEL STREAKS OF CLAY AT 255-260			
290	335	SANDY CLAY			
335	390	FINE TO COARSE SAND & GRAVEL			
390	400	GOLD & BLUE CLAY			

7 CONTRACTOR'S OR LANDOWNER'S CERTIFICATION: This water well was (1) constructed, (2) reconstructed, or (3) plugged under my jurisdiction and was completed on (mo/day/year) 11-23-93 and this record is true to the best of my knowledge and belief. Kansas Water Well Contractor's License No. KWWCL-430. This Water Well Record was completed on (mo/day/yr) 11-23-93 under the business name of HOWARD DRUG CO. BOX 806 BEAVER, OK 73932 by (signature)

INSTRUCTIONS: Use typewriter or ball point pen. PLEASE PRESS FIRMLY and PRINT clearly. Please fill in blanks, underline or circle the correct answers. Send top three copies to Kansas Department of Health and Environment, Bureau of Water, Topeka, Kansas 66620-0001. Telephone: 913-296-5545. Send one to WATER WELL OWNER and retain one for your records.