


WATER WELL RECORD Form WNC-5 KSA 82A-1212

1 LOCATION OF WATER WELL: COUNTY: 047 KEARNY FRACTION: SW 1/4 SW 1/4 SW 1/4 SECTION NUMBER: 26 TOWNSHIP NUMBER: T 23 S RANGE NUMBER: R 35 W

DISTANCE AND DIRECTION FROM NEAREST TOWN OR CITY STREET ADDRESS OF WELL IF LOCATED WITHIN CITY?
FROM DEERFIELD; 1/2 MILE WEST & 2 MILES NORTH

2 WATER WELL OWNER: CLETUS PLOEGER TRUST BOARD OF AGRICULTURE, DIVISION OF WATER RESOURCES
RR#, ST. ADDRESS, BOX #: 221 N. MAIN
CITY, STATE, ZIP CODE: LAKIN, KS 67860-9999 APPLICATION NUMBER:

3 LOCATE WELL'S LOCATION WITH AN "X" IN SECTION BOX:

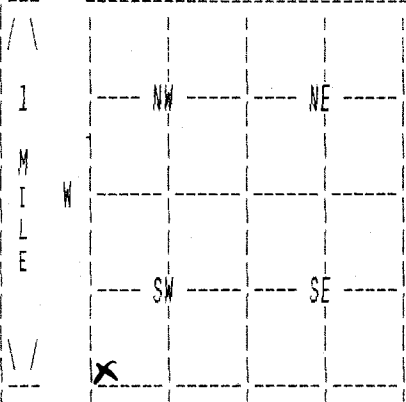

4 DEPTH OF COMPLETED WELL 380 ELEVATION: 0
DEPTH(S) GROUNDWATER ENCOUNTERED 1. 0 FT. 2. 0 FT. 3. 0 FT.
WELL'S STATIC WATER LEVEL 89 FT. BELOW LAND SURFACE MEASURED ON MO/DAY/YR 06/19/01
PUMP TESTDATA: WELL WATER WAS 0 FT. AFTER 0 HOURS PUMPING 0 GPM
ESTIMATED YIELD 0 GPM: WELL WATER WAS 0 FT. AFTER 0 HOURS PUMPING 0 GPM
BORE HOLE DIAMETER 10 IN. TO 380 FT., AND IN. TO 0 FT.
WELL WATER TO BE USED AS: 01 DOMESTIC
WAS A CHEMICAL/BACTERIOLOGICAL SAMPLE SUBMITTED TO DEPARTMENT? No ;
IF YES, MO/DAY/YR SAMPLE WAS SUBMITTED WATER WELL DESINFECTED? Yes

5 TYPE OF BLANK CASING USED: 02 PVC CASING JOINTS: GLUED
BLANK CASING DIAMETER 5 IN. TO 380 FT., DIA IN. TO 0 FT., DIA IN. TO 0 FT.
CASING HEIGHT ABOVE LAND SURFACE 12 IN., WEIGHT 3 LBS/FT. WALL THICKNESS OR GAUGE NO. .265
TYPE OF SCREEN OR PERFORATION MATERIAL: 07 PVC
SCREEN OR PERFORATION OPENINGS ARE: 03 MILL SLOT

SCREEN PERFORATED INTERVALS: FROM 320 FT. TO 380 FT., FROM 0 FT. TO 0 FT.
GRAVEL PACK INTERVALS: FROM 0 FT. TO 0 FT., FROM 0 FT. TO 0 FT.
FROM 20 FT. TO 380 FT., FROM 0 FT. TO 0 FT.
FROM 0 FT. TO 0 FT., FROM 0 FT. TO 0 FT.

6 GROUT MATERIAL 03 BENTONITE
GROUT INTERVALS: FROM 0 FT. TO 20 FT., FROM 0 FT. TO 0 FT., FROM 0 FT. TO 0 FT.
WHAT IS THE NEAREST SOURCE OF POSSIBLE CONTAMINATION: 14 ABAND. WELL
DIRECTION FROM WELL? SOUTH HOW MANY FEET? 100

FROM	TO	LITHOLOGIC LOG	FROM	TO	PLUGGING INTERVALS
0	2	02 SILT			
2	76	01 CLAY 05 SAND			
76	102	05 SAND 13 FINE GRAVEL			
102	120	04 SANDY CLAY 05 SAND			
120	173	05 SAND 13 FINE GRAVEL 01 CLAY			
173	204	05 SAND 13 FINE GRAVEL 04 SANDY CLAY			
204	211	01 CLAY			
211	227	04 SANDY CLAY 05 SAND			
227	233	05 SAND 01 CLAY			
233	250	01 CLAY 04 SANDY CLAY 05 SAND			

7 CONTRACTOR'S OR LANDOWNER'S CERTIFICATION: THIS WATER WELL WAS CONSTRUCTED UNDER MY JURISDICTION AND WAS COMPLETED ON (MO/DAY/YEAR) 06/21/01 AND THIS RECORD IS TRUE TO THE BEST OF MY KNOWLEDGE AND BELIEF. KANSAS WATER WELL CONTRACTOR'S LICENSE NO. 145 THIS WATER WELL RECORD WAS COMPLETED ON (MO/DAY/YR) 07/16/01 UNDER THE BUSINESS NAME OF HENKLE DRILLING & SUPPLY BY (SIGNATURE)

(CONTINUED)

WATER WELL RECORD Form WWC-5 KSA 82A-1212

1 LOCATION OF WATER WELL: COUNTY: 047 KEARNY	FRACTION SW 1/4 SW 1/4 SW 1/4	SECTION NUMBER 26	TOWNSHIP NUMBER T 23 S	RANGE NUMBER R 35 W
---	----------------------------------	----------------------	---------------------------	------------------------

2 WATER WELL OWNER: CLETUS PLOEGER TRUST
 RR#, ST. ADDRESS, BOX #: 221 N. MAIN
 BOARD OF AGRICULTURE, DIVISION OF WATER RESOURCES
 CITY, STATE, ZIP CODE : LAKIN, KS 67860-9999
 APPLICATION NUMBER:

FROM	TO	LITHOLOGIC LOG
250	263	01 CLAY 20 LIMESTONE
263	268	05 SAND 28 ROCK
268	276	07 FINE SAND 08 MEDIUM SAND 01 CLAY
276	302	04 SANDY CLAY 07 FINE SAND 08 MEDIUM SAND
302	328	05 SAND 13 FINE GRAVEL
328	332	04 SANDY CLAY
332	357	05 SAND 13 FINE GRAVEL 01 CLAY
357	377	05 SAND 11 GRAVEL 28 ROCK
377	380	31 CALICHE
380	382	19 SHALE

7 CONTRACTOR'S OR LANDOWNER'S CERTIFICATION: THIS WATER WELL WAS CONSTRUCTED UNDER MY JURISDICTION AND WAS COMPLETED ON (MO/DAY/YEAR) 06/21/01 AND THIS RECORD IS TRUE TO THE BEST OF MY KNOWLEDGE AND BELIEF, KANSAS WATER WELL CONTRACTOR'S LICENSE NO. 145 THIS WATER WELL RECORD WAS COMPLETED ON (MO/DAY/YR) 07/16/01 UNDER THE BUSINESS NAME OF HENKLE DRILLING & SUPPLY BY (SIGNATURE) *Bernie J. Kerkhouth*