

WATER WELL RECORD Form WWC-5 KSA 82A-1212


1 LOCATION OF WATER WELL: COUNTY: **047 KEARNY** FRACTION: **SW 1/4 SW 1/4 SW 1/4** SECTION NUMBER: **26** TOWNSHIP NUMBER: **T 23 S** RANGE NUMBER: **R 35 W**

DISTANCE AND DIRECTION FROM NEAREST TOWN OR CITY STREET ADDRESS OF WELL IF LOCATED WITHIN CITY?
 APPROX. 1/4 MILE WEST & 2 MILES NORTH OF DEERFIELD

2 WATER WELL OWNER: **PLOEGER TRUST, CLETUS** BOARD OF AGRICULTURE, DIVISION OF WATER RESOURCES
 RR#, ST. ADDRESS, BOX #: **221 N MAIN**
 CITY, STATE, ZIP CODE: **LAKIN, KS 67860-9999** APPLICATION NUMBER:

3 LOCATE WELL'S LOCATION WITH AN "X" IN SECTION BOX:

4 DEPTH OF COMPLETED WELL **249** ELEVATION: **0**
 DEPTH(S) GROUNDWATER ENCOUNTERED 1. **0 FT.** 2. **0 FT.** 3. **0 FT.**

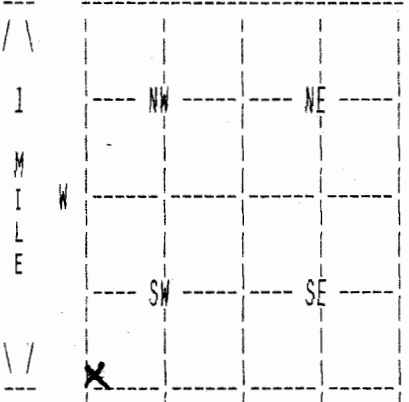

WELL'S STATIC WATER LEVEL **89 FT.** BELOW LAND SURFACE MEASURED ON MO/DAY/YR **06/22/01**
 PUMP TEST DATA: WELL WATER WAS **0 FT.** AFTER **0** HOURS PUMPING **0** GPM

ESTIMATED YIELD **0** GPM: WELL WATER WAS **0 FT.** AFTER **0** HOURS PUMPING **0** GPM

BORE HOLE DIAMETER **0 FT.**, AND **0 FT.**

WELL WATER WAS: **01 DOMESTIC**

WAS A CHEMICAL/BACTERIOLOGICAL SAMPLE SUBMITTED TO DEPARTMENT? **No** ;
 If YES, MO/DAY/YR SAMPLE WAS SUBMITTED WATER WELL DISINFECTED? **Yes**

5 TYPE OF BLANK CASING USED: **01-STEEL** CASING JOINTS: **WELDED**
 BLANK CASING DIAMETER **5** IN. TO **249 FT.**, DIA IN. TO **0 FT.**, DIA IN. TO **0 FT.**
 CASING HEIGHT ABOVE LAND SURFACE **-48** IN. WEIGHT **0** LBS/FT. WALL THICKNESS OR GAUGE NO.
 TYPE OF SCREEN OR PERFORATION MATERIAL: **01-STEEL**
 SCREEN OR PERFORATION OPENINGS ARE: **UNKNOWN**

SCREEN PERFORATED INTERVALS: FROM **0 FT.** TO **0 FT.**, FROM **0 FT.** TO **0 FT.**
 GRAVEL PACK INTERVALS: FROM **0 FT.** TO **0 FT.**, FROM **0 FT.** TO **0 FT.**

6 GROUT MATERIAL **02 CEMENT GROUT**
 GROUT INTERVALS: FROM **4 FT.** TO **380 FT.**, FROM **0 FT.** TO **0 FT.**, FROM **0 FT.** TO **0 FT.**
 WHAT IS THE NEAREST SOURCE OF POSSIBLE CONTAMINATION: **DOMESTIC WELL**
 DIRECTION FROM WELL? **NORTH** HOW MANY FEET? **100**

FROM	TO	LITHOLOGIC LOG	FROM	TO	PLUGGING INTERVALS
			0	4	BACKFILL CONCRETE
			4	380	
			0	0	
			0	0	
			0	0	
			0	0	
			0	0	
			0	0	
			0	0	

7 CONTRACTOR'S OR LANDOWNER'S CERTIFICATION: THIS WATER WELL WAS PLUGGED UNDER MY JURISDICTION AND WAS COMPLETED ON (MO/DAY/YEAR) **06/22/01** AND THIS RECORD IS TRUE TO THE BEST OF MY KNOWLEDGE AND BELIEF. KANSAS WATER WELL CONTRACTOR'S LICENSE No. **145** THIS WATER WELL RECORD WAS COMPLETED ON (MO/DAY/YR) **07/05/01** UNDER THE BUSINESS NAME OF **HENKLE DRILLING & SUPPLY** BY (SIGNATURE) *Brian J. Reichmuth*