


1 LOCATION OF WATER WELL: Fraction Section Number Township Number Range Number
 COUNTY: 047 KEARNY NW 1/4 NW 1/4 SE 1/4 34 T 23 S R 35 W

Distance and direction from nearest town or city street address of well if located within city?
 FROM DEERFIELD; APPX 1 1/2 MILES NORTH

2 WATER WELL OWNER: WAYNE MILLER
 RR#, St. Address, Box #: RT 1 BOX 25 Board of Agriculture, Division of Water Resources
 City, State, ZIP code: DEERFIELD, KS 67838-9501 Application Number: 1856 & 11246

3 LOCATE WELL'S LOCATION WITH AN "X" IN SECTION BOX:

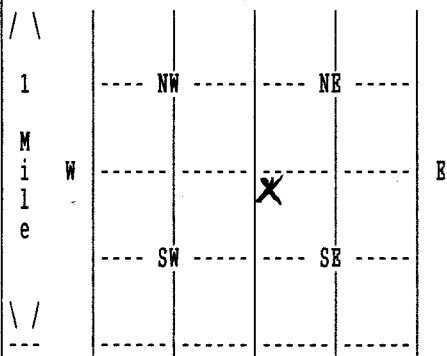

4 DEPTH OF COMPLETED WELL 396 ELEVATION: 0
 Depth(s) Groundwater Encountered 1. 0 ft. 2. 0 ft. 3. 0 ft.

WELL'S STATIC WATER LEVEL 119 ft. below land surface measured on mo/day/yr 08/07/04
 Pump test data: Well water was 261 ft. after 4 hours pumping 1700 gpm

Estimated Yield 0 gpm: Well water was 0 ft. after 0 hours pumping 0 gpm

Bore Hole Diameter 24 in. to 396 ft., and in. to 0 ft.

WELL WATER TO BE USED AS: 02 IRRIGATION

Was a chemical/bacteriological sample submitted to department? No ;
 If yes, mo/day/yr sample was submitted Water well disinfected? Yes

5 TYPE OF BLANK CASING USED: 01 STEEL CASING JOINTS: WELDED
 Blank casing diameter 16 in. to 396 ft., Dia in. to 0 ft., Dia in. to 0 ft.
 Casing height above land surface 12 in., weight 42 lbs/ft. Wall thickness or gauge No. .250
 TYPE OF SCREEN OR PERFORATION MATERIAL: 01 STEEL
 SCREEN OR PERFORATION OPENINGS ARE: 01 CONT. SLOT

SCREEN PERFORATED INTERVALS: From 241 ft. to 391 ft., From 0 ft. to 0 ft.
 From 0 ft. to 0 ft., From 0 ft. to 0 ft.
 GRAVEL PACK INTERVALS: From 20 ft. to 396 ft., From 0 ft. to 0 ft.
 From 0 ft. to 0 ft., From 0 ft. to 0 ft.

6 GROUT MATERIAL 03 BENTONITE
 Grout Intervals: From 0 ft. to 20 ft., From 0 ft. to 0 ft., From 0 ft. to 0 ft.
 What is the nearest source of possible contamination: 14 ABAND. WELL
 Direction from well? NORTH How many feet? 148

FROM	TO	LITHOLOGIC LOG	FROM	TO	PLUGGING INTERVALS
0	1	02 SILT			
1	19	01 CLAY			
19	36	01 CLAY			
36	55	01 CLAY 05 SAND			
55	63	05 SAND 13 FINE GRAVEL 14 MED GRAVEL			
63	83	04 SANDY CLAY 01 CLAY			
83	113	05 SAND 01 CLAY			
113	160	04 SANDY CLAY 05 SAND			
160	170	01 CLAY			
170	177	05 SAND 01 CLAY			

7 CONTRACTOR'S OR LANDOWNER'S CERTIFICATION: This water well was Constructed under my jurisdiction and was completed on (mo/day/year) 08/04/04 and this record is true to the best of my knowledge and belief. Kansas Water Well Contractor's License No. 145 This Water Well Record was completed on (mo/day/yr) 11/05/04 under the business name of HENKLE DRILLING & SUPPLY by (signature)

(Continued)

WATER WELL RECORD Form WWC-5 KSA 82a-1212

1 LOCATION OF WATER WELL: COUNTY: 047 KEARNY	Fraction NW 1/4 NW 1/4 SE 1/4	Section Number 34	Township Number T 23 S	Range Number R 35 W
---	----------------------------------	----------------------	---------------------------	------------------------

2 WATER WELL OWNER: WAYNE MILLER
RR#, St. Address, Box # : RT 1 BOX 25
City, State, ZIP code : DEERFIELD, KS 67838-9501
Board of Agriculture, Division of Water Resources
Application Number: 1856 & 11246

FROM	TO	LITHOLOGIC LOG
177	193	01 CLAY 05 SAND
193	240	01 CLAY 05 SAND
240	283	05 SAND 01 CLAY
283	303	07 FINE SAND 08 MEDIUM SAND 01 CLAY
303	310	05 SAND 13 FINE GRAVEL
310	315	01 CLAY
315	343	05 SAND 13 FINE GRAVEL 01 CLAY
343	391	05 SAND 13 FINE GRAVEL 28 ROCK
391	405	19 SHALE

7 CONTRACTOR'S OR LANDOWNER'S CERTIFICATION: This water well was Constructed under my jurisdiction and was completed on (mo/day/year) 08/04/04 and this record is true to the best of my knowledge and belief. Kansas Water Well Contractor's License No. 145 This Water Well Record was completed on (mo/day/yr) 11/05/04 under the business name of HENKLE DRILLING & SUPPLY by (signature) *Brian J. Henkle*